

RE

MAR 07 2000

FILED

SECTION

Allegan County Remonumentation  
LAND CORNER RECORDATION CERTIFICATE  
Filing Requirement of Act 74, Mich. P.A. 1970

00 FEB -1 AM 8:39

For corners in  
Allegan

Located In:

Corner Code #

(County)

D-10 (Central 1/4 29)  
Dorr Twp.

1. Public Land Survey

T 4N 12W  
R  
T R  
T R  
T R

\_\_\_\_\_  
\_\_\_\_\_  
\_\_\_\_\_  
\_\_\_\_\_  
\_\_\_\_\_  
\_\_\_\_\_

2. Property Controlling  
in Section

S  
S

T R  
T R

\_\_\_\_\_  
\_\_\_\_\_

3. Miscellaneous  
Property in Sec.

S  
S

T R  
T R

\_\_\_\_\_  
\_\_\_\_\_

4. Lot No. \_\_\_\_\_, Recorded Plat \_\_\_\_\_  
5. Private Claims \_\_\_\_\_

*Joyce A. ...*  
REGISTER OF DEEDS  
ALLEGAN COUNTY, MICH.

Register of Deeds Stamp & File Number

I, Steven Koerber, in a field survey on June 4, 1999 do hereby state that under requirements of P.A. 74, Michigan P.A. of 1970, the corner points mentioned in lines 1 and 2 above were in conformance with regulations and rules therefore as required in the current manual of survey instructions of the United States Department of the Interior, Bureau of Land Management or by a decree of a Court of Law and/or that the corner points mentioned in lines 3, 4 and 5 above were in conformance with the rules of the Michigan Board of Land Surveyors or by a Decree of a Court of Law; established, re-established, monumented, recovered, found as expressed below:

NOTE: Not more than 2 corners, all in the same town and range, may be recorded on this certificate.

A	B	C	D	E	F	G	H	I	J	K	L	M
1												
2	6	5		4		3		2		1		
3												
4	7	8		9		10		11		12		
5												
6	18	17		16		15		14		13		
7												
8	19	20		21		22		23		24		
9												
10	30			28		27		26		25		
11												
12	31	32		33		34		35		36		
13												

A. Description of original monument and accessories and/or subsequent restoration:

D-10 GLO - Corner not set 1. Section breakdown notes from old Co. Surv.  
Dist from D-9 to D-10 2687.14' Second dist 2689.64'  
Dist from D-10 to D-11 2630.09' Second dist 2629.47'

2. April 1972  
Act 132 survey  
Medema VanKooten & Assoc  
Iron noted - no wits

(Additional info. on back of sheet)


B. Description of corner evidence found and/or method applied in restoring or reestablishing corner:

D-10 Found Fnd Steel bar  
28" Oak NNW 110.50' (face)  
36" Oak SSW 13.72' (face)  
20" Oak SSE 83.98' (face)  
P.Pole ENE 69.43' (face)  
This corner is accepted as a careful and faithful perpetuation of the position of the original corner.  
Peer Group approval June 8, 1999.  
Dist to D-9= 2689.36' Dist to E-10= 2648.75'  
Dist to D-11= 2629.23' Dist to C-10= 2627.92'

APPROVED REMONUMENTATION CORNER  
P.A. 345 OF 1990  
ALLEGAN COUNTY  
DATE APPROVED JUNE 8, 1999  
COUNTY REP. *[Signature]*

C. Description of monument for corner and accessories established to perpetuate locating the position of the corner:

D-10 Set Standard Allegan Co. Mon. ( 3/4" x 24" Iron Rod with Remon.cap)  
Set nail & Allegan Co. Remon. tag in N. side 12" Maple S80W 18.04'  
Set nail & Allegan Co. Remon. tag in N. side 20" Oak S60E 44.10'  
Set nail & Allegan Co. Remon. tag in NW side 14" Oak N60E 55.40'  
Set nail & Allegan Co. Remon. tag in NE side 36" Oak S15E 85.47'

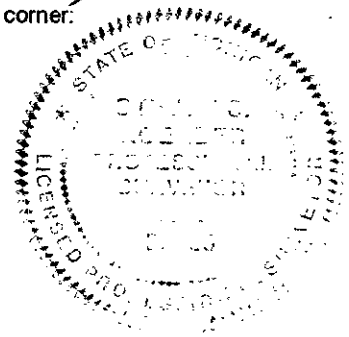

Signed by *Steven Koerber*  
Surveyor's Michigan License No. 39085

Date 8-10-1999

RE... & ...

MAR 07 2000

D-10 DORR TWP.

SECTION

- 3. 7-12-1974  
L.C.R.C. L.2, Pg.316 John Clapp  
Fnd Steel bar  
Fnd. "T" iron E. 0.55' & S. 0.45'  
28" Oak NNW 110.50'  
36" Oak SSW 13.72'  
20" Oak SSE 83.98'  
P.Pole ENE 69.43'
- 4. Witness note sheet - Holland Eng.  
Same as No. 3 above
- 5. 7-12-1974  
Act 132 survey Kistler & Assoc.  
Same as No. 3 above
- 6. 12-29-1976  
Act 132 survey Kistler & Assoc  
Same wits as No. 3 above
- 7. 11-21-1980  
Act 132 survey Exxel Eng. L. 989, Pg. 774  
Nail in side 28" Oak NNW 110.50'  
Nail in Side 36" Oak SSW 13.72'  
Nail in side 20" Oak SSE 83.98'  
P.Pole ENE 69.43'

LIBERO 007 MAR 22 2000