APR 0 7 1998

| | | .000 | Allegan | County | Remonumenta | tion · | | | | | |
|---|---|---|---|--|---|--|------------------------------------|---|--------------------------|--------|----------|
| | | | LAND CORNE | R RECO | RDATION CERT | TIFICATE | | 00 | 98 | | |
| For | COMPSETCTIO | N | | | Act 74, Mich. P | | | 302 | | | 77] |
| | Allegan (County) | Loca | ated In: | Corn | er Code ## | | 0 M 4 9 | SISIER SISIER | JAN 21 | | = |
| 1. | Public Land Surve | T_ | 4N R 12W | | (N1, 3) Twp. | | Qual to see | ななど | PH 1: 2 | | |
| 3. | Property Controlling in Section Miscellaneous Property in Sec. | T_ng ST_ ST_ ST_ | R R R R R R | | | Reg | ister of D | eeds Star | | e Nur | nber |
| 4. | Lot No. | _ , Recorded Plat _ | | | <u> </u> | | . B | C 0 E | F R H | | |
| I do he in lin curre Mana abov Courr expre | John C. Buece ereby certily that undi- les 1 and 2 above we ent manual of survey agement or by a decre e were in conformant 1 of Law; established essed below; | he in a lield surver requirements of P.A. ere in conformance winstructions of the Unseloi a Court of Law and ce with the rules of the ed, re-established, m | ey onApri .74, Michigan P.A. o ith regulations and ited States Departe d/or that the corner Michigan Soard of nonumented, re-mo | 1 28 I 1970, the crules there ent of the points men Land Surve onumented | corner points menti- clore as required in interior, Bureau of I tloned in lines 3, 4 a tyors or by a Decree , recovered, found | n the Land and 5 | 2 6 3 4 7 5 6 18 7 8 19 9 10 30 | 5 - 17 1 17 1 | 5 15- 1 | 14 | |
| NOTE: Not more than 4 corners, all in the same town and range, may be recorded on this certificate. | | | | | | | 11 12 31 | | | | |
| A. 1 | Description of origi | inal monument and | accessories and/ | or subsec | uent restoration: | | 13 | | , | | 36 |
| | H-1 GLO Not set | LCRC L1, P188, A Fnd. 3/4" solid iro. Spk. in side 30" N Spk. in side 14" V C/L st. sign post V West edge stop s Spk. in side 16" T 76.90' Iron (S'/4 34, 5-12) | n daple ENE 62.48 V. Cherry NE 27 WSW 43.60' ign post SSE 61 riple Box Elder E | .31' | LCRC L2, P48 Fnd. 3/4" solid Wit. same as I Survey 1985 J Cast iron Mon. SW cor, conc. N&T E side 15 | iron left onker . E 7.0' HW N 80 | O° E 92.1: | - | (stump |) | |
| B. C | escription of corni | er evidence found a | | plied in re | | | orner: | | | | • |
| | line of Tow Meas. Wes | capped rerod 7.02 nship to the North st to NW cor. 3 262 t to NE cor. 3 2629 | 39.67' 9.79' | | (S¼ 34, 5-12) of | | rth | | | | |
| | | on not established t available evidenc | by original gove | ernment s | urveyors. This r | | nt is acce | pted | | | |
| | | oup approved Ma | · · | | | DATE | | L 345 OF 19 EGAN COU | % NTY <i>13-97</i> | _ | <u> </u> |
| D. D | escription of monu | ment for corner and | d accessories est | ablished t | o perpetuate loca | ating the g | position of | the corn | er: | | |
| | H-1 Replac in bit. road Nail & Ken SW cor. co NW cor. co | ced capped rerod v t Co. Remon. Tag onc. headwall N 78 onc. headwall N 69 side 8" Maple N 30 | with Allegan Co; in SW side 6" x 1° E 88.30' 1° E 92.93' | Mon. (3/4 | I" x 24" pin with | cap in co | | - | CHI CHI | ** * * | |


C/L gravel road South, West 10'± Kent Co. Mon. East 7.02' (S¼ 34, 5-12)

Signed by John C. Bueche, Surveyor's Michigan License No.

 $^{\circ} \text{ USER} 0006 \text{PAGE} 071$

Sheet 1 of 2

CP Co. worksheet Dist. West 2653.78' to NW 3 Dist. East 2629.90' to NE 3

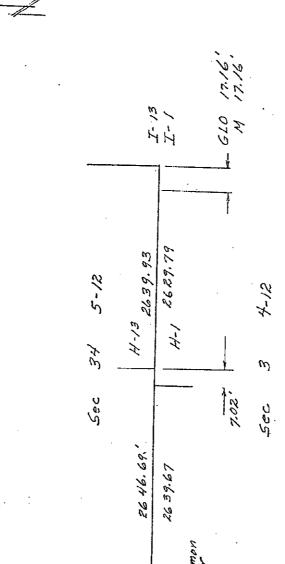

Sheet 2