

SURVEY & REMONUMENTATION

9-2

APR 07 1998

Allegan County Remonumentation
LAND CORNER RECORDATION CERTIFICATE
Filing Requirement of Act 74, Mich. P.A. 1970

For corners in SECTION

| Allegan (County) | Located In: | Corner Code # |
|------------------------------------|-------------|---------------|
| 1. Public Land Survey | T 4N R 12W | ✓ I-1 (NE, 3) |
| | T R | Dorr Twp. |
| | T R | |
| | T R | |
| 2. Property Controlling in Section | S T R | |
| | S T R | |
| 3. Miscellaneous Property in Sec. | S T R | |
| | S T R | |

JAMES A. BUECHE
 REGISTER OF RECORDS
 ALLEGAN COUNTY, MICH.


98 JAN 21 PM 1:21

FILED

Register of Deeds Stamp & File Number

4. Lot No. _____, Recorded Plat _____
 5. Private Claims _____

I, John C. Bueche, in a field survey on April 28, 19 97, do hereby certify that under requirements of P.A. 74, Michigan P.A. of 1970, the corner points mentioned in lines 1 and 2 above were in conformance with regulations and rules therefore as required in the current manual of survey instructions of the United States Department of the Interior, Bureau of Land Management or by a decree of a Court of Law and/or that the corner points mentioned in lines 3, 4 and 5 above were in conformance with the rules of the Michigan Board of Land Surveyors or by a Decree of a Court of Law; established, re-established, monumented, re-monumented, recovered, found as expressed below:

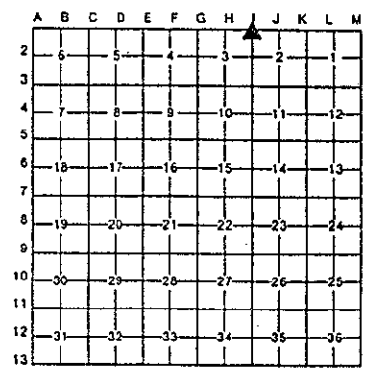

NOTE: Not more than 4 corners, all in the same town and range, may be recorded on this certificate.

A. Description of original monument and accessories and/or subsequent restoration:

| | | |
|---|--|--|
| I-1 GLO May, 1831 Lucius Lyon, DS Intersect N. boundary 26 lks W of post Set post cor. secs. 2 & 3 Beech 30 S 59 E 35 Beech 12 S 79 W 21 | LCRC L1, P41, June, 1971 Stone 13x6x5 18" deep 3/4" iron over stone PP S 40° W 57.0' 20" Cherry S 20° W 61.55' St. sign N 45° E 43.0' | LCRC L2, P48, Dec., 1972 Set "T" iron 17.16' W of SE cor. 34, 5-12 as per former surveys PK SE side CP pole S 24° W 47.83' Spk. NE side cor. fence post N 21° W 40.44' PK NE side MBT pole S 82° E 90.64' Bit. spk. E side 20" W. Cherry S 60.64' Iron 17.16' OVER |
|---|--|--|

B. Description of corner evidence found and/or method applied in restoring or reestablishing corner:

| | | |
|---|----------------------------|--|
| I-1 Found 1/2" rerod 17.16' W of SE 34, 5-12 in bit. road on South line of Township to the North Meas. West 2629.79' Meas. East | 20" Cherry S 20° W 61.55'± | PK SE side CP pole S 24° W 47.83'± Bit. spk. E side 20" W. Cherry S 60.64'± |
|---|----------------------------|--|

And is accepted as a careful and faithful perpetuation of the position of the original corner.


Traverse H-13 to I-13 2639.93'

Peer group approved May 13, 1997.

APPROVED REMONUMENTATION CORNER
 P.A. 345 OF 1990
 ALLEGAN COUNTY
 DATE APPROVED 5-13-97
 COUNTY REP. K.V.D.

C. Description of monument for corner and accessories established to perpetuate locating the position of the corner:

- I-1 Left 1/2" rerod & placed Allegan Co. Cap on rerod (stone 18" deep as per LCRC L1, P41)
- Nail & Kent Co. Remon. Tag in SE side PP S 24° W 48.97'
- Nail & Kent Co. Remon. Tag in W side PP N 5° W 148.82'
- SE cor. hse. N 32° W 180.95'
- NW cor. garg. fnd. S 52° W 161.32'
- Pole barn spk. in E side 20" W. Cherry S 3° E 61.39'
- Kent Co. Mon. East 17.16' (SE cor. 34, 5-12)
- C/L bit North, East 17'±; C/L bit E-W
- C/L gravel South, East 17'±

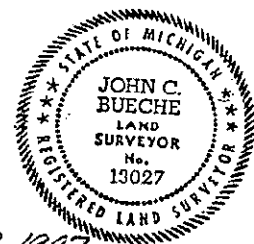

Signed by John C. Bueche
 Surveyor's Michigan License No. 13027

Date Sept 12, 1997

FORM APPROVED BY MICHIGAN STATE BOARD OF LAND SURVEYORS, JAN. 28, 1971
 REVISED MAY 14, 1975
 REVISED JAN., 1983

REFR 0006 PAGE 073

Sheet 1 of 2

LCRC L3, P295, Sept., 1980
 Set capped rerod 17.16' West of SE cor. 34, 5-12 per previous surveys
 PK in side PP S 35° W 48.80'
 Spk. in side 20" W. Cherry S 61.40'
 Spk. in side 6" W. Cherry N 60° W 70.33'
 1/2" iron E 17.16'

L890, P269 Survey
 CP Co., Aug., 1976
 Fnd. "T" iron 0.7' W & 1.1' S of sec. cor.
 Set temp. spk.
 1 1/2" iron (SW 35, 5-12) East 17.16'
 PP S 20° W 49.10'
 St. sign N 50° E 53.80'
 Rebar N 35° E 36.69'

