

MAR 1 6 1994

Alleghan County Remonumentation
LAND CORNER RECORDATION CERTIFICATE
Filing Requirement of Act 74, Mich. P.A. 1970

COMPASSION
of corners in
Alleghan
(County)

Located in: Leighton Twp & Dorr Twp

Corner Code #


1. Public Land Survey	T	R	
	T	4N	R 11W
	T	R	
	T	4N	R 12W
2. Property Controlling in Section	S	T	R
	S	T	R
3. Miscellaneous Property in Sec.	S	T	R
	S	T	R

1993 DEC 30 PM 2:47
 REGISTER OF DEEDS
 ALLEGAN COUNTY MICH
 Register of Deeds Stamp & File Number

FILED

4. Lot No. _____, Recorded Plat _____

5. Private Claims _____

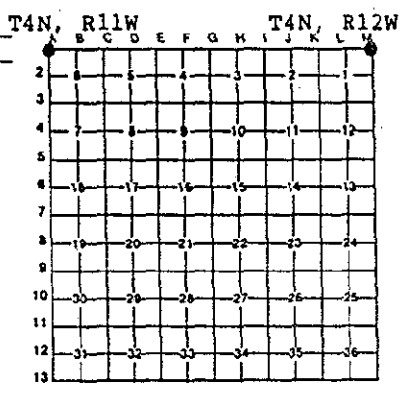

I, Robert Jonker, in a field survey on October 25, 1993, do hereby certify that under requirements of P.A. 74, Michigan P.A. of 1970, the corner points mentioned in lines 1 and 2 above were in conformance with regulations and rules therefore as required in the current manual of survey instructions of the United States Department of the Interior, Bureau of Land Management or by a decree of a Court of Law and/or that the corner points mentioned in lines 3, 4 and 5 above were in conformance with the rules of the Michigan Board of Land Surveyors or by a Decree of a Court of Law; established, re-established, monumented, re-monumented, recovered, found as expressed below:

NOTE: Not more than 4 corners, all in the same town and range, may be recorded on this certificate.


- A. Description of original monument and accessories and/or subsequent restoration:
- | | |
|---|---|
| A-1, 1974, Duane Aukron
3/8" Rod in Concrete
Iron fence corner N. 75° W 46.6' | M-1, MSHD, 1956, Iron in Pavement
From Road Maps
14" Elm N 36° W 30.75'
28" Maple N 75° W 47.47'
30" Maple S 55° W 47.15' |
|---|---|

Corner common to 4 townships per G.L.O. maps.

- B. Description of corner evidence found and/or method applied in restoring or reestablishing corner:
- Found Harrison mon. on C/L N-S pavt. as recorded in Kent Co. as the corner common to 4 townships.
- As per the 1974 wit. listed in "A" above.

Accepted as the best available evidence of the position of the original corner.

- C. Description of monument for corner and accessories established to perpetuate locating the position of the corner:
- Harrison Monument in Pavement
- | | |
|--------------------------|-------------------|
| Fd. N&T SW side P. pole | Az. 303°, 99.0' |
| Fd. N&T NE side 10" Ash | Az. 314°, 69.48' |
| Set N&T SE side 10" Ash | Az. 227°, 73.12' |
| NW cor conc loading dock | Az. 139°, 132.42' |
- Capped Iron E. 33.02'
on C/L old roadbed to West
on field division line to the East
- B-1, East 2629.88'

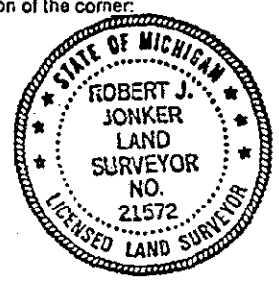

Signed by Robert J. Jonker Date 12-29-93
 JONKER LAND SURVEYS
 Surveyor's Michigan License No. 21572

FORM APPROVED BY MICHIGAN STATE BOARD OF LAND SURVEYORS, JAN. 26, 1971
 REVISED MAY 24, 1975
 REVISED JAN., 1983

LIBER 004 PAGE 297