

**ALLEGAN COUNTY REMONUMENTATION
LAND CORNER RECORDATION CERTIFICATE
Filing Requirement of Act 74, Mich. P.A. 1970**

LIBR0006 PAR366

For corners in

Allegan
(County)

Located In: Dorr Twp. Corner Code # _____

1. Public Land Survey

T 4N R 12W M-4
T _____ R _____
T _____ R _____
T _____ R _____

2. Property Controlling in Section

S _____ T _____ R _____
S _____ T _____ R _____

3. Miscellaneous Property in Sec.

S _____ T _____ R _____
S _____ T _____ R _____

FILED

1/28/1999 2:44:39 PM

JOYCE A. WATTS
REGISTER OF DEEDS
ALLEGAN COUNTY, MICH

Register of Deeds Stamp & File Number

4. Lot No. _____, Recorded Plat _____
5. Private Claims _____

I, Robert J Jonker, in a field survey on 10-22, 1998 do hereby state that under requirements of P.A. 74, Michigan P.A. of 1970, the corner points mentioned in lines 1 and 2 above were in conformance with regulations and rules therefore as required in the current manual of survey instructions of the United States Department of the Interior, Bureau of Land Management or by a decree of a Court of Law and /or that the corner points mentioned in lines 3, 4 and 5 above were in conformance with the rules of the Michigan Board of Land Surveyors or by a Decree of a Court of Law, established, re-established, monumented, recovered, found as expressed below:

NOTE: Not more than 2 corners, all in the same town and range, may be recorded on this certificate.

	A	B	C	D	E	F	G	H	I	J	K	L	M
1													
2	6	5	4	3	2	1							
3													
4	7	8	9	10	11	12							
5													
6	18	17	16	15	14	13							
7													
8	19	20	21	22	23	24							
9													
10	30	29	28	27	26	25							
11													
12	31	32	33	34	35	36							
13													

A. Description of original monument and accessories and/or subsequent restoration:

G.L.O. - North -East side 12
40.00 set qr. sec. post
sugar 9 S26W 20
Sugar 9 N60W 24

(see additional info over)

B. Description of corner evidence found and/or method applied in restoring or reestablishing corner:


Found 1/2" rod in mon box.

And is accepted as a careful and faithful perpetuation of the position of the original corner.

APPROVED REMONUMENTATION CORNER
P.A. 345 OF 1990
ALLEGAN COUNTY
DATE APPROVED NOV. 24, 1998
COUNTY REP. Robert J. Jonker

C. Description of monument for corner and accessories established to perpetuate locating the position of the corner:

Replaced with std. Allegan Co. Mon.
Found nail in SW side 34" oak N32°W 46.64'
Found nail in S. side basswood clump S78°E 43.15'
NW Gar. cor fundation S40°E 120.78'
Allegan con Remon pin in mon box South 9.20'
Set nail & tag in S. side P. pole N79°W 26.0'

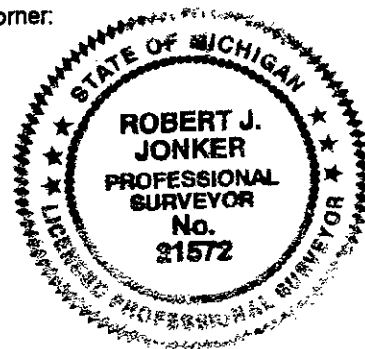

Traverse M-4 M-3, 2647.04'
Traverse M-4 M-5, 2645.38'

Signed by Robert J. Jonker
Surveyor's Michigan License No. 21572

Date 11-9-98

Sheet 1 of 2

M-4 DORR TWP.

- | | |
|--|---|
| 1. old witness map - (ratekin) no date
found 3/4" pipe
Guy pole W. 17.75'
T. pole E 22.5'
24" oak NW 44.7' | <u>10-22-98</u>

out
out
check ok |
| 2. recorded surveys in L. 1239 on p. 371 & 372 (1989)
Excel eng. - Doug Bonnema
P.K. SW side p. pole NW 89.3'
Nail SE side 22" hickory sw 64.65'
Dbl. nail- E. side - 20" Hick. nw 168.31"
SW Cor. fr. hse #4703 NE 96.39' |

out
out
out
out |
| 3. Excel eng. rec. survey - l. 1061, P. 191
1/2" rod in mon box
3/4" rod in mon box S. 9.23'
Nail - Ely root - 36" maple NW 44.46'
Nail - sly side clump - basswoods E 43.9'
Nail NW side 12" Elm NE 62.56'
NW cor. gar. fnd. SE 120.71' |

check ok
check ok
out
out
out
check ok |

LIBERO 006 PAGE 367

SEARCHED
SERIALIZED
INDEXED
FILED