

RF

MAR 6 7 2000

FILED

SECTION

Alleghan County Remonumentation
LAND CORNER RECORDATION CERTIFICATE
Filing Requirement of Act 74, Mich. P.A. 1970

00 FEB -1 AM 8:39

For corners in

Alleghan

(County)

Located In:

Dorr Twp.

Corner Code #

1. Public Land Survey

T 4N R 12W

M-10

T R

T R

T R

2. Property Controlling
in Section

S

T R

S

T R

3. Miscellaneous
Property in Sec.

S

T R

S

T R

4. Lot No. _____, Recorded Plat _____

5. Private Claims _____

Joyce A. White
REGISTER OF DEEDS
ALLEGAN COUNTY, MICH.

Register of Deeds Stamp & File Number

I, Robert J Jonker, in a field survey on 12-10, 1999 do hereby state that under requirements of P.A. 74, Michigan P.A. of 1970, the corner points mentioned in lines 1 and 2 above were in conformance with regulations and rules therefore as required in the current manual of survey instructions of the United States Department of the Interior, Bureau of Land Management or by a decree of a Court of Law and /or that the corner points mentioned in lines 3, 4 and 5 above were in conformance with the rules of the Michigan Board of Land Surveyors or by a Decree of a Court of Law; established, re-established, monumented, recovered, found as expressed below:

NOTE: Not more than 2 corners, all in the same town and range, may be recorded on this certificate.

1	A	B	C	D	E	F	G	H	I	J	K	L	M
2		6		5		4		3		2		1	
3													
4		7		8		9		10		11		12	
5													
6		18		17		16		15		14		13	
7													
8		19		20		21		22		23		24	
9													
10		30		29		28		27		26		25	
11													
12		31		32		33		34		35		36	
13													

A. Description of original monument and accessories and/or subsequent restoration:

GLO survey North-east side Sec. 25 - 1826
40.0 ch. Beech - 6 for qr. sec. post

APPROVED REMONUMENTATION CORNER
P.A. 345 OF 1990
ALLEGAN COUNTY

DATE APPROVED DEC. 14, 1999
COUNTY REP [Signature]

over

B. Description of corner evidence found and/or method applied in restoring or reestablishing corner:


Fd. 1/2" sq. spike by wit. listed on "A" (over)
Removed & replaced with 36" Alleghan Co. pin & tag

And is accepted as a careful and faithful perpetuation of the position of the original corner.

Peer group approved 12-14-99 Road traverse M-10 M-9 2643.20'
Road traverse M-10 M-11 2643.37'

C. Description of monument for corner and accessories established to perpetuate locating the position of the corner:

3/4" X 36" std. Alleghan Co. Monument
Nail in p. pole SE 94.27'
Nail in p. pole W 20.72'
Nail in post E 37.59'
A-10 (West 1/4 sec. 30 Leighton) South 13.28'

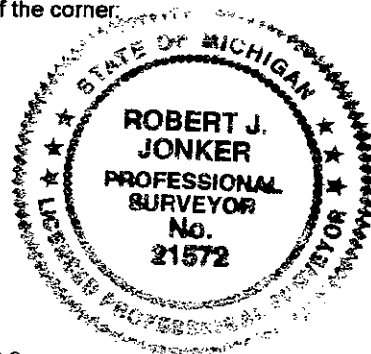

Signed by Robert J. Jonker
Surveyor's Michigan License No. 21572

Date 12-14-99

MAR 07 2000

Part "A" cont. M-10

SECTION

Jonker - 1999

1. Old Sectional break down of Sec.
by E. Strong DS - 1869
S $\frac{1}{2}$ = 40.14 ch.
N $\frac{1}{2}$ = 40.09 ch.
call is for a 16 X 12 X 8 stone

2. LCRC #3-294 MVK 1979
Part B fd. $\frac{1}{2}$ " sq. rod @ midpoint of mile
Part C
Nail in p. pole SE 94.15'
Nail in P. pole W. 20.94'
Nail in post E. 36.22'
A-10 (West $\frac{1}{4}$ Sec. 30 Leighton)
South 13.28'

 $\frac{1}{2}$ " sq. spike
Check OK
Check OK
Check OK
Check OK

3. Recorded survey, Jonker - 1984
same as A & B above

4. Ratekin wit. card - 1985
Resites MVK wit. & adds
C/L 12th Street (gravel) East 4'+-
In line with fence to W & E
Check OK
Check OK

5. Holland Eng.
Same as #2 above

MEMO 007 PAGE 235