

REF
MAR 07 2000

FILED

SECTION

ALLEGAN COUNTY REMONUMENTATION
LAND CORNER RECORDATION CERTIFICATE
Filing Requirement of Act 74, Mich. P.A. 1970

FEB -1 AM 8:39

RECORDED 07 PAGE 236

For corners in Allegan (County) Located In: Dorr Twp. Corner Code #

1. Public Land Survey T 4N R 12W M-11
T R
T R
T R

2. Property Controlling in Section S T R
S T R
S T R

3. Miscellaneous Property in Sec. S T R

4. Lot No. _____, Recorded Plat _____

5. Private Claims _____

Joyce A. Smith
REGISTER OF DEEDS
ALLEGAN COUNTY, MICH.

Register of Deeds Stamp & File Number

| A | B | C | D | E | F | G | H | I | J | K | L | M |
|----|----|----|----|----|----|----|---|---|---|---|---|---|
| 1 | | | | | | | | | | | | |
| 2 | 6 | 5 | 4 | 3 | 2 | 1 | | | | | | |
| 3 | | | | | | | | | | | | |
| 4 | 7 | 8 | 9 | 10 | 11 | 12 | | | | | | |
| 5 | | | | | | | | | | | | |
| 6 | 18 | 17 | 16 | 15 | 14 | 13 | | | | | | |
| 7 | | | | | | | | | | | | |
| 8 | 19 | 20 | 21 | 22 | 23 | 24 | | | | | | |
| 9 | | | | | | | | | | | | |
| 10 | 30 | 29 | 28 | 27 | 26 | 25 | | | | | | |
| 11 | | | | | | | | | | | | |
| 12 | 31 | 32 | 33 | 34 | 35 | 36 | | | | | | |
| 13 | | | | | | | | | | | | |

I, Robert J Jonker, in a field survey on 12-10-99, 1999 do hereby state that under requirements of P.A. 74, Michigan P.A. of 1970, the corner points mentioned in lines 1 and 2 above were in conformance with regulations and rules therefore as required in the current manual of survey instructions of the United States Department of the Interior, Bureau of Land Management or by a decree of a Court of Law and/or that the corner points mentioned in lines 3, 4 and 5 above were in conformance with the rules of the Michigan Board of Land Surveyors or by a Decree of a Court of Law; established, re-established, monumented, recovered, found as expressed below:

NOTE: Not more than 2 corners, all in the same town and range, may be recorded on this certificate.

A. Description of original monument and accessories and/or subsequent restoration:
GLO survey - N. on E. side 36 - 1826
80.0 ch. set post cor. 25 and 36
Sugar 9 N 62 W 22
Sugar 6 S 24 W 23


APPROVED REMONUMENTATION CORNER
P.A. 345 OF 1990
ALLEGAN COUNTY
DATE APPROVED DEC. 14, 1999
COUNTY REP. *[Signature]*

B. Description of corner evidence found and/or method applied in restoring or reestablishing corner:
over
M-11: found 3/4" X 21" steel pin by wit. listed in "A" above removed & replaced with 36" Allegan Co. remon pin & cap

Road traverse M-11 M-10 2643.37'
Road traverse M-11 M-12 2670.94'

And is accepted as a careful and faithful perpetuation of the position of the original corner. Peer group approved 12-14-99

C. Description of monument for corner and accessories established to perpetuate locating the position of the corner:
3/4" X 36" std. Allegan Co. Monument
S70°E 26.09' - C/L E. end 12" CMP
N70°W 28.16' - C/L W. end 12" CMP
N40°W 27.45' SE Cor. tel. cable outlet
S35°W 64.2' (leaning) - NE Cor. tel. cable outlet
South 26.55' - "T" iron - Leighton Cor.

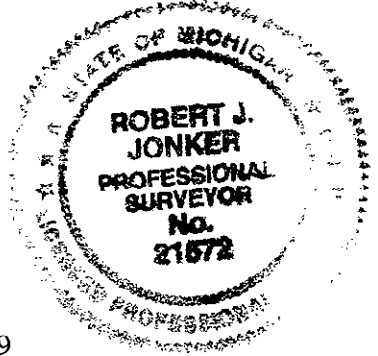

Signed by *Robert J. Jonker*
Surveyor's Michigan License No. 21572

Date 12-13-99

Part "A" cont. M-11

Jonker - 1999

1. Old survey by E. Strong DS - 1869
Distance North $\frac{1}{2}$ mile - 40.14 ch.
calls for stone 20 X 8 X 8 (page 132)

PROPERTY &
RECORDS SECTION

MAR 07 2000

2. LCRC #2-82 Ratekin - 1972
Part B - set 1" iron from previous
surveys & jog dist. which was S. 26.4'
Part "C" - same wit. as # 3

SECTION

3. Wit. card - no date (estimate 70's +/-)
1" iron on top of 12" CMP
C/L E. end 12" CMP S80°E 16.45'
C/L E. end 12" CMP N80°W 15.5'
SE Cor. tel. cable outlet N50°W 27.6'
NE Cor. tel. cable outlet S35°W 64.0'
T. iron South 26.4' - Lieghton Cor.

Check OK
S70°E 26.09'
N70°W 28.16'
N40°W 27.45'
S35°W 64.2' (leaning)
26.55'

4. Recorded Survey - Ratekin - Liber 821, P. 704
Same wit. as LCRC

5. Recorded survey by Ratekin - Liber 899, P. 469, 1976
Same wit. as LCRC

6. Recorded survey, Jonker
1984 - fd. 3/4" steel pin
PK nail NW side P. Pole S30°W 65.6'
PK nail W side G. pole S30°E 67.25'
SPK NW side 9" Elm N85°E 40.2'

Fd. 3/4" Steel pin
65.64'
66.97'
Out

7. Holland Eng. - Same wit. as LCRC

LIBRARY / MAR 23 /