

MAR 07 2000

FILED

SECTION

ALLEGAN COUNTY REMONUMENTATION

LAND CORNER RECORDATION CERTIFICATE 00 FEB -1 AM 8:39  
Filing Requirement of Act 74, Mich. P.A. 1970

For corners in

Allegan (County)	Located In: Dorr Twp.	Corner Code #
1. Public Land Survey	T 4N R 12W	M-12
	T R	
	T R	
	T R	
2. Property Controlling in Section	S T R	
	S T R	
3. Miscellaneous Property in Sec.	S T R	
	S T R	

*Joyce Williams*  
REGISTER OF DEEDS  
ALLEGAN COUNTY, MICH.

Register of Deeds Stamp & File Number

4. Lot No. \_\_\_\_\_, Recorded Plat \_\_\_\_\_  
5. Private Claims \_\_\_\_\_

I, Robert J Jonker, in a field survey on 12-10, 1999 do hereby state that under requirements of P.A. 74, Michigan P.A. of 1970, the corner points mentioned in lines 1 and 2 above were in conformance with regulations and rules therefore as required in the current manual of survey instructions of the United States Department of the Interior, Bureau of Land Management or by a decree of a Court of Law and/or that the corner points mentioned in lines 3, 4 and 5 above were in conformance with the rules of the Michigan Board of Land Surveyors or by a Decree of a Court of Law; established, re-established, monumented, recovered, found as expressed below:

NOTE: Not more than 2 corners, all in the same town and range, may be recorded on this certificate.

	A	B	C	D	E	F	G	H	I	J	K	L	M
1													
2		6		5		4		3		2		1	
3													
4		7		8		9		10		11		12	
5													
6		18		17		16		15		14		13	
7													
8		19		20		21		22		23		24	
9													
10		30		29		28		27		26		25	
11													
12		31		32		33		34		35		36	
13													

A. Description of original monument and accessories and/or subsequent restoration:

GLO survey - North on East side of 36, 1826  
40.0 ch. set post  
Sugar 9 S10 W 18  
B. Ash 9 N62 W 67

APPROVED REMONUMENTATION CORNER  
P.A. 345 OF 1990  
ALLEGAN COUNTY  
DATE APPROVED DEC. 14, 1999  
COUNTY REP. [Signature]

over

B. Description of corner evidence found and/or method applied in restoring or reestablishing corner:

M-12: Found 3/4" X 21" steel pin removed & replaced with 36" Allegan Co., Remon Pin & Cap


And is accepted as a careful and faithful perpetuation of the position of the original corner.

Road traverse M-12 M-11 2670.94'  
Road traverse M-12 M-13 2632.73'

Peer group approved 12-14-99

C. Description of monument for corner and accessories established to perpetuate locating the position of the corner:

3/4" X 36" std. Allegan Co. Monument  
Allegan co. remon Nail & tag in North side  
24" Basswood S20°E 67.96'  
6" Basswood N35°W 48.37' (South side)  
6" Basswood N75°W 62.25' (NE side)  
C/L road as traveled & brush row to West.  
Leighton Corner S. 5.95'

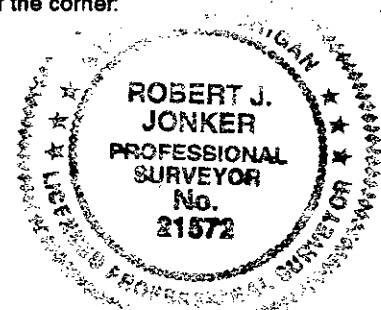

Signed by Robert J. Jonker  
Surveyor's Michigan License No. 21572

Date 12-13-99

LIBR00007 MAR 23 1999

Part "A" Cont. M-12

Jonker - 1999

- 1. Ratekin - 1967 1/2" pipe Witness card  
 6" poplar S20°W 75.2'  
 1" poplar S50°W 38.5'  
 West 1/4 post Sec. 31-4-12  
 South 5.83'

Out  
 Out  
 South 5.95' (measured)

- 2. Ratekin - 1972 Rd. 1" iron  
 Distance South 2632.75'  
 Distance North 2670.81'

RF  
 MAR 07 2000

Found 1" iron  
 South dist. 2632.73' (mea.)  
 North dist. 2670.94' (mea.)

- 3. Ratekin survey - 1976  
 Same wit. as (1) above

SECTION

- 4. Shows jog of 5.83' South to  
 Leighton corner  
 (Ratekin Survey of 1982)

5.95'

- 5. Ratekin survey - 1983  
 Same wit. as (1) above

LIBRARY / MAR 23 1999