

**Allegan County Remonumentation
LAND CORNER RECORDATION CERTIFICATE**
Filing Requirement of Act 74, Mich. P.A. 1970

For corners in
Allegan
(County)


Located In: Corner Code #

1. Public Land Survey	T <u>4N</u> R <u>13W</u>	* <u>A-1</u> (NW 6)
	T _____ R _____	Salem Twp.
	T <u>4N</u> R <u>14W</u>	<u>M-1</u> (NE 1)
	T _____ R _____	Overisel Twp.
2. Property Controlling in Section	S _____ T _____ R _____	_____
3. Miscellaneous Property in Sec.	S _____ T _____ R _____	_____

97 JAN 22 9 11 AM '96
 REGISTER OF DEEDS ALLEGAN COUNTY
 FILED
 Register of Deeds Stamp & File Number

4. Lot No. _____, Recorded Plat _____
 5. Private Claims _____

I, John C. Bueche, in a field survey on September 30, 19 96, do hereby certify that under requirements of P.A. 74, Michigan P.A. of 1970, the corner points mentioned in lines 1 and 2 above were in conformance with regulations and rules therefore as required in the current manual of survey instructions of the United States Department of the Interior, Bureau of Land Management or by a decree of a Court of Law and/or that the corner points mentioned in lines 3, 4 and 5 above were in conformance with the rules of the Michigan Board of Land Surveyors or by a Decree of a Court of Law; established, re-established, monumented, re-monumented, recovered, found as expressed below:

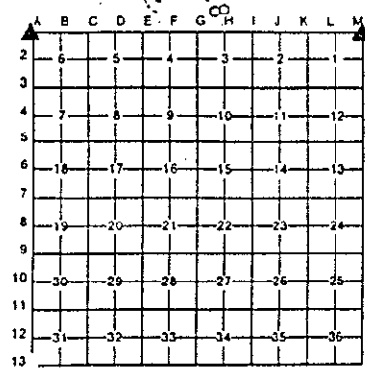

NOTE: Not more than 4 corners, all in the same town and range, may be recorded on this certificate.

A. Description of original monument and accessories and/or subsequent restoration:

A-1 & A-13 GLO	LCRC L1-P284	Ottawa Co. LCRC
Lucius Lyon, D.S.	"T" iron	L3, P173 Remon.
Nov., 1831	May, 1972	Dec., 1995
Existing cor.	GP N 40 W 45.62'	
B. Ash 7 N 50 E 19	PP S 40 W 48.0'	
B. Ash 6 S 56 W 11	GP S 40 E 56.2'	
	2" steel post 14.7'	

B. Description of corner evidence found and/or method applied in restoring or reestablishing corner:

A-1 & A-13
 Found Ottawa Co. Mon. As per above wit.
 And is accepted as a careful and faithful perpetuation of the position of the original corner
 Approved by Ottawa Co. Peer Group 12/11/95
 Approved by Allegan Co. Peer Group 10/8/96

APPROVED REMONUMENTATION CORNER
 P.A. 345 OF 1990
 ALLEGAN COUNTY
 DATE APPROVED 10-8-96
 COUNTY REP. John C. Bueche

C. Description of monument for corner and accessories established to perpetuate locating the position of the corner:

A-1 & A-13 Ottawa Co. Mon. (3/4" Pin with Ottawa Co. Cap)
 Nail & Ottawa Co. Remon. Tag in SE side PP S 40 W 48.90'
 Nail & Ottawa Co. Remon. Tag in SW side GP S 40 E 56.58'
 Nail & Ottawa Co. Remon. Tag in SE side PP N 60 E 51.96'
 Nail & Ottawa Co. Remon. Tag in S side GP N 40 W 45.74'
 C/L gravel rd. N-S, East 5'±, on old fence East, on South woods West

97 JAN 22 9 11 AM '96
 REGISTER OF DEEDS ALLEGAN COUNTY
 FILED
 JOHN C. BUECHE
 LAND SURVEYOR
 No. 13027
 STATE OF MICHIGAN
 LAND SURVEYORS BOARD
 FORM APPROVED BY MICHIGAN LAND SURVEYORS BOARD JAN. 28, 1971
 REVISED MAY 14, 1975
 REVISED JAN., 1983

Signed by John C. Bueche, P.S. Date 10-6-96
 Surveyor's Michigan License No. 13027