

RF

MAR 07 2000

ALLEGAN COUNTY REMONUMENTATION  
LAND CORNER RECORDATION CERTIFICATE  
Filing Requirement of Act 74, Mich. P.A. 1970

REGISTER OF DEEDS  
ALLEGAN COUNTY  
*Joyce A. Smith*

00 FEB - 1 AM 8 49

FILED  
JAN 07 1999

SECTION

For corners in

<u>Allegan</u> (County)	Located In:	Corner Code #
1. Public Land Survey	T <u>4N</u> R <u>13W</u>	<u>A-11</u> <u>Salem Twp.</u>
	T ___ R ___	_____
	T ___ R ___	_____
	T ___ R ___	_____
2. Property Controlling in Section	S ___ T ___ R ___	_____
	S ___ T ___ R ___	_____
3. Miscellaneous Property in Sec.	S ___ T ___ R ___	_____
	S ___ T ___ R ___	_____

Register of Deeds Stamp & File Number

4. Lot No. \_\_\_\_\_, Recorded Plat \_\_\_\_\_  
5. Private Claims \_\_\_\_\_

I, Kirk L Van Order, in a field survey on Oct 10, 1999 do hereby state that under requirements of P.A. 74, Michigan P.A. of 1970, the corner points mentioned in lines 1 and 2 above were in conformance with regulations and rules therefore as required in the current manual of survey instructions of the United States Department of the Interior, Bureau of Land Management or by a decree of a Court of Law and/or that the corner points mentioned in lines 3, 4 and 5 above were in conformance with the rules of the Michigan Board of Land Surveyors or by a Decree of a Court of Law; established, re-established, monumented, recovered, found as expressed below:

NOTE: Not more than 2 corners, all in the same town and range, may be recorded on this certificate.

	A	B	C	D	E	F	G	H	I	J	K	L	M
1													
2		6		5		4		3		2		1	
3													
4		7		8		9		10		11		12	
5													
6		18		17		16		15		14		13	
7													
8		19		20		21		22		23		24	
9													
10		30		29		28		27		26		25	
11													
12		31		32		33		34		35		36	
13													

A. Description of original monument and accessories and/or subsequent restoration:

A-11  
(1) GLO  
West between Sections 30 & 31  
78.40 to W. boundary 70 lks N. of post  
Set post cor. Sections 30 & 31 for wit.  
Beech 10" dia. S.34E. 32 lks.  
Beech 8" dia. N.12E. 30 lks.

APPROVED REMONUMENTATION CORNER  
P.A. 345 OF 1990  
ALLEGAN COUNTY  
DATE APPROVED Nov. 9, 1999  
COUNTY REP. *[Signature]*

(continued on back of sheet)

B. Description of corner evidence found and/or method applied in restoring or reestablishing corner:

A-11  
Fd. 1-1/4" x 30" steel rod 0.01' East of range line and the witnesses as listed in No. 6 above.  
Removed steel rod and set a standard Allegan Co. Remon. monument on range line. And is accepted as a careful and faithful perpetuation of the position of the original corner.  
Peer group approved Nov. 9, 1999.

Traversed distance = 5299.91 feet on road.


C. Description of monument for corner and accessories established to perpetuate locating the position of the corner:

A-11  
Standard Allegan Co. Remon. monument (3/4" x 36" steel rod w/red cap #23520)  
Nail & Remon. tag in S side 41" w. oak AZ 305° 24.00'  
Nail & Remon. tag in NE side 10" spruce AZ 330° 47.09'  
Nail & Remon. tag in NW side power pole AZ 30° 85.47'  
Nail & Remon. tag in SW side 12" s. pine AZ 140° 61.46'  
M-11, T.4N., R.14W. Remon. iron AZ 180° 46.20'

(continued on back of sheet)

Signed by \_\_\_\_\_  
Surveyor's Michigan License No. VAN ORDER 23520

Date 12-30-1999

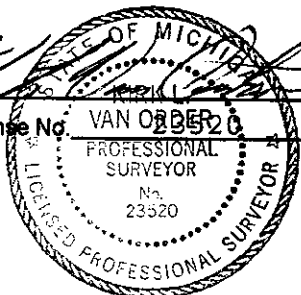

MAR 07 2000

SECTION

LIBRO 004 / PAGE 23

Section A (continued from Page 1)

A-11

Salem Twp., T.4N., R.13W.

- (2) LCRC recorded in Liber 004 on Page 81 by Robert J. Jonker, dated May 3, 1989  
 Set corner 70 links (46.2') North of Overisel Twp. corner  
 1" x 30" solid rod  
 Spk. S. side 36" oak                    N.55°W.            24.27'  
 Iron    South                46.2'  
 Nail - NW side p. pole                N.30°E.            85.37'  
 Nail - N. side 8" pine                S.85°E.            45.64'  
 C/L road to E. is                        N.                    24'  
 C/L N-S road is                         East                 14'
- (3) Tri-County Land Surveys, P.C., survey date Oct. 7, 1985  
 Shows SW cor., Sec. 30, T.4N., R.13W. with no ties
- (4) Wightman-Moored, Inc. corner card  
 Section 30 Salem Twp.  
 SW cor. iron w/cap by Jonker  
 (Same info as in No. 2)
- (5) Holland Engineering, Inc. info.  
 Fd. 1" iron 87  
 Overisel cor.                            S.                    46.26  
 C/L 36th gravel                         E.                    15.00  
 C/L 138th gravel                        N.                    26.00  
 Nail SW side 36" oak                 WNW                24.28  
 Nail in side PP                         NE                    85.33  
 1" x 30" solid rod Jonker 90  
 (Same info. as in No. 2)
- (6) Kirk L. Van Order survey, dated May 16, 1996  
 NW corner  
 Section 31, T.4N., R13W.  
 Fd. 1" steel rod  
 Spike in S. side 36" oak               N.55°W.            24.27'  
 Iron    South                46.2'  
 Nail in NW side power pole           N.30°E.            85.37'  
 Nail in N. side 8" pine                S.85°E.            45.64'  
 C/L road to East                        N.                    24'  
 C/L road is East                         14'

Section C

C/L gravel road	AZ 90°	10.5'
M-10 T.4N., R.14W.	AZ 00°	2607.92'
Fd. 5/8" iron pipe	AZ 00°	25.97'
C/L gravel road to East	AZ	26'