
For corperation TION ATTEGRAT (County) 1. Public Land Survey 2. Property Controlling in Section	LAND	Salem Twp.	TIFICATE P.A. 1970 – F	98 JAN 21 PH 1: 35	FILED
3. Miscellaneous Property in Sec.	S T R S T R		Register of D	eeds Stamp & File t	Number
4. Lot No, F 5. Private Claims	in a field survey on	April 4 , 19 97 In P.A. of 1970, the corner points mens and rules therefore as required Department of the Interior, Bureau of corner points mentioned in lines 3, oard of Land Surveyors or by a Decity re-monumented, recovered, for	2 6 3 4 7 7 7 5 1 1 1 1 1 1 1 1 1 1 1 1 1 1 1 1	C D E F G M	1 J K L M
NOTE: Not more than 4 con this certificate.		wn and range, may be recorde	d 11 12 31-	32 33 34	35 36
B-1 GLO Wi Not set PP St S APPROVED REMC PA. ALLE DATE APPROVED COUNTY REP.	t. card ESE 11.00' . sign WNW 10.4 1/4 Sec. 31 W 3. NUMENTATION CORNER 3450F 1990 GAN COUNTY 5-/3-97 K.V.O.	Rd. ext. to Rd. ext. to	1 Jonker Sec. 31 N 3 e PP N 90° E le barn S 45 le barn S 60 o South 0' W o North 35' 1	° E 56.65' ° W 87.78' est	
B-1 Found 1" North using, Meas. W to SW Meas. E to SE Kirk Van Orde	solid rod 0.22' the S 1/4 cor. cor. Sec. 31 2 cor. Sec. 31 2 r 2 not establishe is accepted as the corner.	North of the South 31, 5-13 & the SE Check wit. 
Description of monume B-1 Set Alleg 5-13 & SE 31 Nail & Ottawa NW cor. metal SW cor. metal SE cor. metal On C/L gravel On fence & br On power line Ottawa Co. Mo	an Co. Mon. on , 5-13) 0.22' S Co. Remon. Tag shed S 42° E 5 shed S 18° E 1 shed S 58° W 9 shed S 72° W 8 rd. South externsh row East	29.13' 8.38' 7.44' Inded North Pers) 1, 5-13 West 34.73	between S 1 r. ° E 11.08'	of the corner: /4 31, Of Mic * JOHN C * BUECHE 1AND SURVEYOR 13027	**
Signed by John C. Bue Surveyor's Michigan Licens	che, P.S.	Date	FORM APPROVED BY MICHIE	AN STATE BOARD HAVEN	TORS. JAN. 28. 1871
1857	0006 _{PAGE} 203	Sheet 1 of 2	e pope con research in the second		EYISED MAY 14, 1875 REYISED JAX., 1863

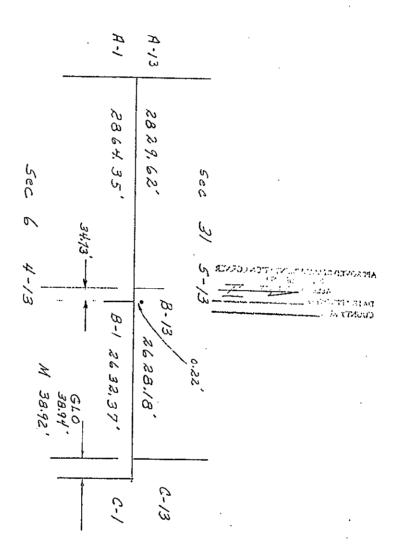

Sheet 2 of 2