

SURVEY & REMONUMENTATION

APR 07 1998

**Allegan County Remonumentation
LAND CORNER RECORDATION CERTIFICATE
Filing Requirement of Act 74, Mich. P.A. 1970**

SECTION


For corners in

Allegan (County)	Located In:	Corner Code #
1. Public Land Survey	T <u>4N</u> R <u>13W</u>	<u>C-1 (NE, 6)</u>
	T _____ R _____	<u>Salem Twp.</u>
	T _____ R _____	_____
	T _____ R _____	_____
2. Property Controlling in Section	S _____ T _____ R _____	_____
	S _____ T _____ R _____	_____
3. Miscellaneous Property in Sec.	S _____ T _____ R _____	_____
	S _____ T _____ R _____	_____

98 JAN 21 PM 1:35
 REGISTER OF DEEDS
 ALLEGAN COUNTY, MICH.
 REGISTERED
 FILED
 Register of Deeds Stamp & File Number

4. Lot No. _____, Recorded Plat _____
 5. Private Claims _____

I, John C. Bueche, in a field survey on April 15, 19 97, do hereby certify that under requirements of P.A. 74, Michigan P.A. of 1970, the corner points mentioned in lines 1 and 2 above were in conformance with regulations and rules therefore as required in the current manual of survey instructions of the United States Department of the Interior, Bureau of Land Management or by a decree of a Court of Law and/or that the corner points mentioned in lines 3, 4 and 5 above were in conformance with the rules of the Michigan Board of Land Surveyors or by a Decree of a Court of Law; established, re-established, monumened, re-monumented, recovered, found as expressed below:

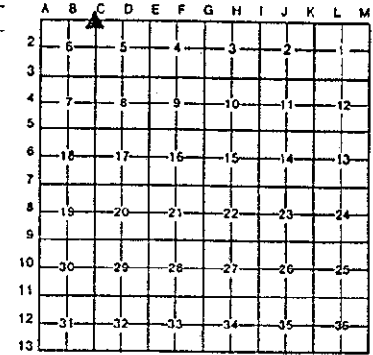

NOTE: Not more than 4 corners, all in the same town and range, may be recorded on this certificate.

A. Description of original monument and accessories and/or subsequent restoration:

C-1 GLO, 1831	CP Co. found rebar, 1976	Survey May 1994 Kirk Van Order
Lucius Lyon, DS	PP S 80° E 28.80'	1/2" rerod
North boundary	TP N 65° W 69.91'	Ottawa Co. Sec. cor. W 38.91'
59 Lks E of post	Rd. sign N 50° W 66.63'	Nail in S side PP ESE 28.59'
(38.94')	SE cor. 31, 5-13 West	Nail in side PP WSW 73.39'
	38.94'	C/L tel. pedestal NW 71.34'
	Dist. E to S 1/4 32, 5-13	Nail in SW side 50" Box Elder
	2652.11'	SE 103.91'
		C/L gravel rd. W 21'
		Dist. W to N 1/4 Sec. 6 2593.40'

B. Description of corner evidence found and/or method applied in restoring or reestablishing corner:

C-1 Found 1/2" rerod on South line Twp. to the North; on C/L gravel road South extended North
 On fence & brush row West
 On power line (poles) West

As per above wit.

And is accepted as a careful and faithful perpetuation of the position of the original corner.

Traverse C-13 to D-13 2653.92'
 See sketch on back


Peer group approved May 13, 1997.

C. Description of monument for corner and accessories established to perpetuate locating the position of the corner:

C-1 Replaced 1/2" rerod with Allegan Co. Mon. (3/4" x 24" pin with cap) on South line of Twp. to the North
 Nail & Ottawa Co. Remon. Tag in N side PP S 90° W 73.39'
 Nail & Ottawa Co. Remon. Tag in W side PP N 05° W 259.68'
 Nail & Ottawa Co. Remon. Tag in N side PP S 70° E 28.64'
 Nail & Ottawa Co. Remon. Tag in W side PP S 07° E 235.96'
 SW cor. trailer (3' above ground) S 46° E 96.67'
 On C/L gravel rd. South extended North
 Ottawa Co. Mon. (SE 31, 5-13) West 38.92'
 C/L CP towers E-W North 275'±

Signed by John C. Bueche, P.S. Date 1-3-97
 Surveyor's Michigan License No. 13027

APPROVED REMONUMENTATION CORNER
 P.A. 345 OF 1990
 ALLEGAN COUNTY
 DATE APPROVED 5-13-97
 COUNTY REP. K.V.C.

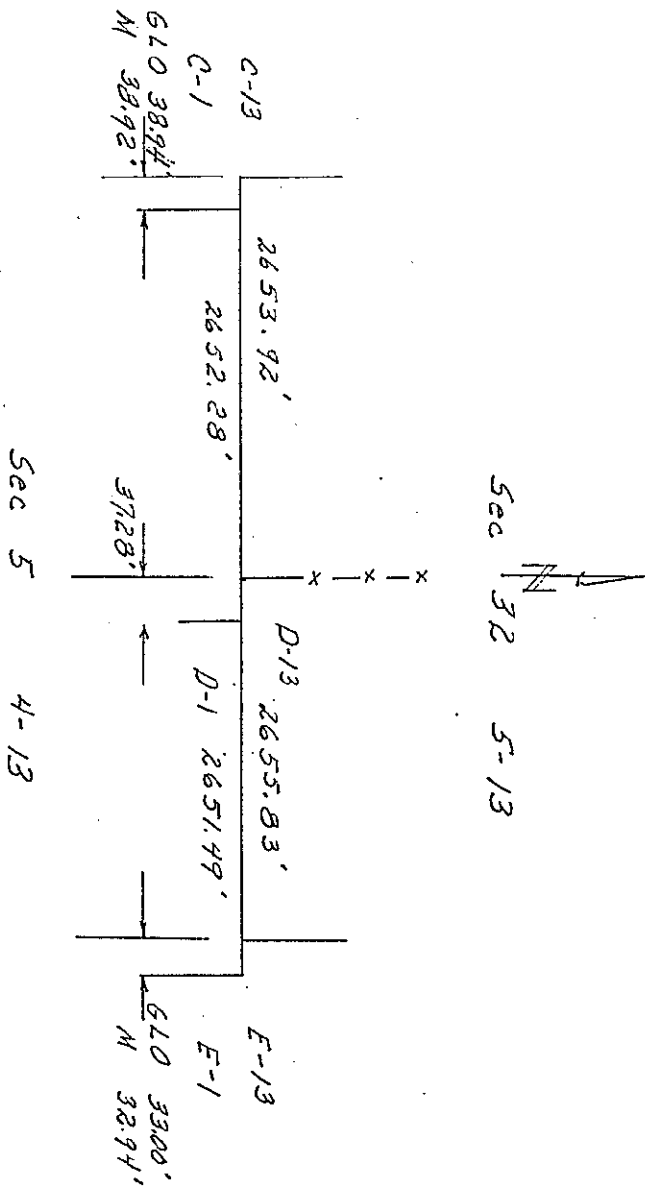

