

**SURVEY
REMONUMENTATION**

APR 29 1999

**ALLEGAN COUNTY REMONUMENTATION
LAND CORNER RECORDATION CERTIFICATE
Filing Requirement of Act 74, Mich. P.A. 1970**

SECTION

For corners in

ALLEGAN Located In: Salem Twp. Corner Code #
(County)

1. Public Land Survey T 4N R 13W C-3
T R NE SEC 7
T R
T R

2. Property Controlling S T R
in Section S T R
3. Miscellaneous S T R
Property in Sec. S T R

LIBER0007 PAGE065

FILED
1/28/1999 2:44:39 PM
JOYCE A. WATTS
REGISTER OF DEEDS
ALLEGAN COUNTY, MICH
Register of Deeds Stamp & File
Number


4. Lot No. _____, Recorded Plat _____
5. Private Claims _____

I, Robert E. Lemke, in a field survey on May 20, 1998 do hereby state that under requirements of P.A. 74, Michigan P.A. of 1970, the corner points mentioned in lines 1 and 2 above were in conformance with regulations and rules therefore as required in the current manual of survey instructions of the United States Department of the Interior, Bureau of Land Management or by a decree of a Court of Law and/or that the corner points mentioned in lines 3, 4 and 5 above were in conformance with the rules of the Michigan Board of Land Surveyors or by a Decree of a Court of Law; established, reestablished, monumented recovered, found as expressed below:

	A	B	C	D	E	F	G	H	I	J	K	L	M
1													
2	6		5		4		3		2		1		
3													
4	7		8		9		10		11		12		
5													
6	18		17		16		15		14		13		
7													
8	15		20		21		22		23		24		
9													
10	30		29		28		27		26		25		
11													
12	31		32		33		34		35		36		
13													

NOTE: Not more than 2 corners, all in the same town and range, may be recorded on this certificate.

- A. Description of original monument and accessories and/or subsequent restoration:
(see back of page)
- B. Description of corner evidence found and/or method applied in restoring or reestablishing corner:
Found 1/4" solid Iron rod, over Stone w/ "X" in Monument Box
P.K. & nail & Washer on W. side P.pole S23° W 127.10' (Measured 127.15' to stump of old Power pole)
P.K. & nail & Washer on SW. side P.pole N31° W 68.04' (Measured 67.90' to PK)
P.K. on W. side t. Pole S49° W 46.79' (Measured 47.38' to PK)
C/L "X" B.T. 2' N m/1 (Measured 1.40')
Pulled 1/4" Iron and left Stone w/ "X" in Monument box
And is accepted as a careful and faithful perpetuation of the position of the original corner.
- C. Description of monument for corner and accessories established to perpetuate locating the position of the corner:
Set standard Allegan County monument (3/4" x 6" steel rod w/ red cap #23520)
Pulled 1/4" iron and grouted Into Monument Box & Set over "x" in Stone
- Nail & Al. Co. Remon tag on the West side of a Power pole 2.6' above grade N 22° W 67.84'
Face of 3" steel post (Gas line marker post) N 78° E 79.50'
Nail & Al. Co. Remon tag in the top of a 6" wooden fence corner post S 25° E 41.98'
Nail & Al. Co. Remon tag on the West side of an 8" wooden post 1.6' above grade S 52° W 47.40'

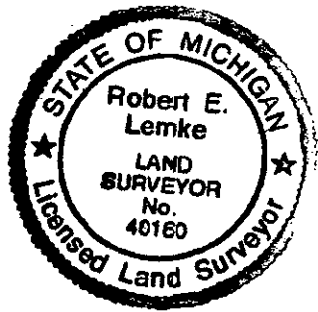

APPROVED REMONUMENTATION CORNER
P.A.345 OF 1990
ALLEGAN COUNTY
DATE APPROVED NOV. 10, 1998
COUNTY REP. [Signature]

Signed by Robert E. Lemke
Surveyor's Michigan License No. 40160 for SDI Consultants

Date 12/29/98

FORM APPROVED BY MICHIGAN STATE BOARD OF PROFESSIONAL SURVEYORS,
JAN. 23, 1971
REVISED MAY 14, 1975
REVISED JAN., 1983
REVISED OCT., 1995

SURVEY
REMONUMENTATION

APR 29 1993

C-3
SALEM TWP

SECTION

A. Description of original monument and accessories and/or subsequent restoration: C-3 continued:

GLO

set post cor. Sec.'s 5,6,7,& 8
W. Ash 8 in. Dia bears S 67°E 25 Lks.
B. Ash 10 in. Dia. Bears N 67° W 9 Lks.

County Survey Notes
old notes, unknown date

NE Cor. Sec. 7
Found Stone
P.K. Nail in Tele Pole SE 44.47'
SW Corner Concrete Headwall NNE 55.84'
SE Corner Concrete Headwall NNW 55.75'
P.K. Nail in Power Pole NW 68.00'
P.K. Nail in Power Pole SW 127.07'

County Survey Notes

SW Cor. Sec. 5
Found Rebar 2' S. of CL blacktop
Road Sign S45° E 35.85'
SW Cor Conc. Hd.Wall NNE 55.84'
SE Cor. Conc. Hd. Wall NNW 55.75'
P.Pole NW 68.00'

Witness Card Sec. 5-4-13 Salem Twp.

Source unknown
SW Cor. Sec. 7
1/4 solid rod 2' S. of CL XT.
Fd. PK nail & Washer on W. Side P.P. S 23°W 127.10'
Fd. PK nail & Washer on SW. Side P.P. N 31°W 68.04'
Set PK on W. side T. Pole S49° W 46.79'
Set PK on W side 60" Maple N7° E 43.44'

County Witness Card

Section 5 Salem Township
SW corner
CPC Found Rebar 2' S of CL Blacktop
Road Sign S 45° +/- E 35.85'
SW cor. Conc. HD>Wall NNE 55.84'
SE cor. Conc. HD.Wall NNW 55.75'
Ppole NW 68.00'
R. Jonker 7-6-81
FD 1/4" Iron
PK w/washer W. side P.Pole S23° W 127.10'
PK w/ washer SW side P.Pole N31° W 68.04'
PK on W. side T. Pole S49° W 46.79'
PK on W. side 60" Maple N7°E 43.44'
CL B.Top 2' N +/-

Survey

Ratekin 1969
Shows Southwest Corner Sec 5, T4N, R13W
at CL 34th ST and at CL 146th Ave.

County Witness Card

Section 6 Salem Township
SE Cor Stone Iron over
PK Nail in Tel. Pole SE 44.47'
SW Cor. Conc. Hd.WL NNE 55.84'
SE Cor. Conc. Hd.WL NNW 55.75'
PK Nail in P.Pole NW 68.0'
PK Nail in P.Pole SW 127.07'

LCRC Liber 3, Page 312

R. Jonker July 18, 1981
Found 1/4" solid rod
P.K. & nail & Washer on W. side P.pole S23° W 127.10'
P.K. & nail & Washer on SW. side P.pole N31° W 68.04'
P.K. on W. side t. Pole S49° W 46.79'
P.K. on W. side 60" Maple N7°E 43.44'
C/L "X" B.T. 2' N m/1

Holland Engineering Witness Card

FD 1/4" Solid Rod Jonk.
Same witness's as LCRC Liber 3, Page 312
FD Stone
same witness's as County Witness Card Section 6 Salem Township

LIBER 007 PAGE 66