

**SURVEY
REMONUMENTATION**

APR 29 1999

**ALLEGAN COUNTY REMONUMENTATION
LAND CORNER RECORDATION CERTIFICATE
Filing Requirement of Act 74, Mich. P.A. 1970**

SECTION

For corners in

ALLEGAN Located In: Salem Twp. Corner Code #
(County)

1. Public Land Survey T 4N R 13W C-4
T R E 1/4 SEC 7
T R
T R

2. Property Controlling S T R
in Section S T R
3. Miscellaneous S T R
Property in Sec. S T R

4. Lot No. , Recorded Plat

5. Private Claims

LIBERO 007 PAGE 067


FILED
1/28/1999 2:44:39 PM
JOYCE A. WATTS
REGISTER OF DEEDS
ALLEGAN COUNTY, MICH
Register of Deeds Stamp & File
Number

	A	B	C	D	E	F	G	H	I	J	K	L	M
1													
2	6		5		4		3		2		1		
3													
4	7	▼	8		9		10		11		12		
5													
6	18		17		16		15		14		13		
7													
8	19		20		21		22		23		24		
9													
10	30		29		28		27		26		25		
11													
12	31		32		33		34		35		36		
13													

I, Robert E. Lemke, in a field survey on May 20, 1998 do hereby state that under requirements of P.A. 74, Michigan P.A. of 1970, the corner points mentioned in lines 1 and 2 above were in conformance with regulations and rules therefore as required in the current manual of survey instructions of the United States Department of the Interior, Bureau of Land Management or by a decree of a Court of Law and/or that the corner points mentioned in lines 3, 4 and 5 above were in conformance with the rules of the Michigan Board of Land Surveyors or by a Decree of a Court of Law; established, reestablished, monumented, recovered, found as expressed below:

NOTE: Not more than 2 corners, all in the same town and range, may be recorded on this certificate.

- A. Description of original monument and accessories and/or subsequent restoration:
(see back of page)
- B. Description of corner evidence found and/or method applied in restoring or reestablishing corner:
Found Iron Pipe 3/4" ID w/ cap
Witness's per County Survey card 1986
2639.15' S of NE Cor. (measured = 2639.23')
2639.15' N of SE Cor. (measured = 2639.21')
1" Iron 7.24' E & 1' S +/- on E. side of Rd. (measured = 7.35')
Removed this Iron.
Witness per KVO survey 3/24/89
SE Cor. Brick Ret. Wall N, NW 169.58' (measured 127.90')
And is accepted as a careful and faithful perpetuation of the position of the original corner.
- C. Description of monument for corner and accessories established to perpetuate locating the position of the corner:
Set standard Allegan County monument (3/4" x 24" steel rod w/ red cap #23520)
This monument is set over old Iron and is 0.40' Below Gravel Road Surface
CL 38th ST. East 2.0' +/-
SE Corner Brick Retaining Wall N60 ° W 127.90'
Nail & Al.Co. Remon tag in the NW side of a 6" Elm, 5.0' above grade N 43 ° E 29.20'
Nail & Al.Co. Remon tag in the W side of a 3" Ash, 4.5' above grade S 19 ° E 49.64'
Nail & Al.Co. Remon tag in the N side of a 6" Ash, 1.6' above grade S 64 ° W 57.51'
Nail & Al.Co. Remon tag in the N side of a 16" Maple, 0.7' above grade S 77 ° W 64.44'

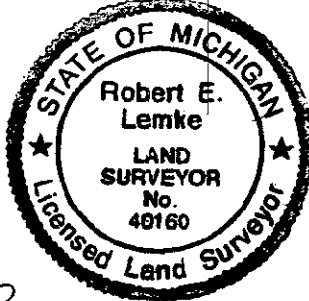

APPROVED REMONUMENTATION CORNER
P.A.345 OF 1990
ALLEGAN COUNTY
DATE APPROVED NOV. 10, 1998
COUNTY REP. [Signature]

Signed by Robert E. Lemke Date 12/29/98
Surveyor's Michigan License No. 40160 for SDI Consultants

SURVEY
REMONUMENTATION

APR 20 1990

C-4 SALEM TWP.

SECTION

A. Description of original monument and accessories and/or subsequent restoration: C-4 continued:

GLO

North between Sec 7 & 8

40.00 Ch.

W. Ash 8 in. Dia. bears N 9°W 10 Lks.

Butternut 4 in. Dia. Bears S 58° E 14 Lks.

Consumers Power Co.

old notes, unknown date

E 1/4 post Sec. 7

Set Iron (East side of Road)

Power Pole SW 75.6'

Corner Fence Post WSW 83.0'

18" Oak WSW 105.54'

Distance to NE corner Sec 7 2639.47'

Distance to SE corner Sec 7 2639.47'

County Witness Card

Section 7 Salem Township

E 1/4 post

East side of Road

Power Pole SW 75.6'

Corner Fence Post WSW 83.0'

18" Oak WSW 105.54'

1986

E 1/4 Post FD Iron w/ cap #21272

2639.15' S of NE Cor.

2639.15' N of SE Cor.

On Line Between =#21272

1" Iron 7.24' E & 1' S +/- on E. side of Rd.

PK in SE side P. pole # 40 SSW 73.20'

PK in N. side Cor FE. Post WSW 76.64'

CL DR. West S 3' +/-

Unrecorded Survey

D.A. Ratekin

unknown date

E 1/4 post, Sec.7, T4N, R13W Salem Twp.

Iron on East side of Rd.

Power Pole SW 75.6'

Corner Fence Post WSW 83.0'

18" Oak WSW 105.54'

Unrecorded Survey

Kirk Van Order March 24, 1989

shows W 1/4 corner Sec. 8, T4N, R13W

FD. Capped Iron

18" Basswood N. NE 90.0'

Power Pole S, SW 73.20'

Corner Fence Post W, SW 76.64'

NE Cor Brick Ret. Wall NW 128.10'

SE Cor. Brick Ret. Wall N, NW 169.58'

Holland Engineering Witness Card

C-4

Set Iron (E side of RD)

PP SW 75.60

Cor FC Post WSW 83.00

18" Oak WSW 105.54

LIBERO 007 PAGE 68