

APR 29 1999

ALLEGAN COUNTY REMONUMENTATION
LAND CORNER RECORDATION CERTIFICATE
Filing Requirement of Act 74, Mich. P.A. 1970

SECTION

For corners in


<u>Allegan</u> (County)	Located In: Salem Twp (Township)	Corner Code #
1. Public Land Survey	T 4N R 13W	C-5
	T ___ R ___	SE cor SEC 7
	T ___ R ___	_____
	T ___ R ___	_____
2. Property Controlling	S ___ T ___ R ___	_____
3. in Section	S ___ T ___ R ___	_____
3. Miscellaneous	S ___ T ___ R ___	_____
Property in Sec.	S ___ T ___ R ___	_____

FILED
1/28/1999 2:44:39 PM
JOYCE A. WATTS
REGISTER OF DEEDS
ALLEGAN COUNTY, MICH
Register of Deeds Stamp & File Number

LIBR0007 PASFO69

4. Lot No. _____, Recorded Plat _____
5. Private Claims - _____

I, Robert E. Lemke, surveyor, in a field survey on ⁵⁻²⁰⁻⁹⁸~~5-20-98~~ do hereby state that under requirements of P.A. 74, Michigan P.A. of 1970, the corner points mentioned in lines 1 and 2 above were in conformance with regulations and rules therefore as required in the current manual of survey instructions of the United States Department of the Interior, Bureau of Land Management or by a decree of a Court of Law and/or that the corner points mentioned in lines 3, 4 and 5 above were in conformance with the rules of the Michigan Board of Land Surveyors or by a Decree of a Court of Law; established, re-established, monumented, recovered, found as expressed below:

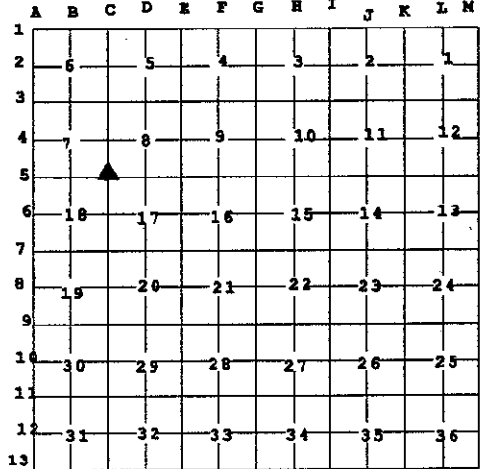

NOTE: Not more than 2 corners, all in the same town and range, may be recorded on this certificate.

- A. Description of original monument and accessories and/or subsequent restoration:
(see back of page)
- B. Description of corner evidence found and/or method applied in restoring or reestablishing corner:
Found 1/2" iron in Monument Box
Witness's per KVO Survey 12/20/1988
NE cor Sec 18
FD 3/4" steel rod
r.r. tie cor. Post NE, 42.30' (Measured 42.50')
10" pin cherry SE, 49.55' (Measured 49.60')
power pole SW, 36.98' (Measured 37.20')
USGS #0158 BM SW, 38.55' (Found destroyed laying on ground)


And is accepted as a careful and faithful perpetuation of the position of the original corner.

- C. Description of monument for corner and accessories established to perpetuate locating the position of the corner:
Set standard Allegan County monument (3/4" x 24" steel rod w/red cap #23520) this monument replaced found 1/2" iron and is set 0.4' below road surface in existing monument box.
Set nail & Al. Co. tag in top of 6" wood corner post, N 30°W, 43.62'
Set nail & Al. Co. tag East side of RR tie fence post 1.6' above grade, N 49°E, 42.50'
Set nail & Al. Co. tag NE side of 6" Cherry 0.4' above grade, S 14° E, 49.71'
Set nail & Al. Co. tag NW side of power pole 1.8' above grade, S 55° W, 37.15'

APPROVED REMONUMENTATION CORNER
P.A.345 OF 1990
ALLEGAN COUNTY
DATE APPROVED NOV. 10, 1998
COUNTY REP. *[Signature]*

Signed by *Robert E. Lemke*
Surveyor's Michigan License No. 40160 for SDI Consultants

Date 12/29/98

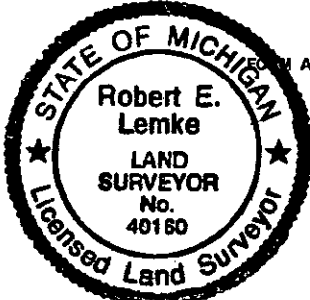

APPROVED BY MICHIGAN STATE BOARD OF PROFESSIONAL SURVEYORS,
JAN. 26, 1971
REVISED MAY 14, 1975
REVISED JAN., 1983
REVISED OCT., 1995

SURVEY
REMONUMENTATION

APR 29 1999

C-5 SECTION
SALEM TWP.

A. Description of original monument and accessories and/or subsequent restoration: C-5 continued

GLO Notes

80.00ch N of SE Cor Sec 18,
Set post, common Sec. 7, 8, 17 & 18
Beech 12 in N12.5°W 18 lks
Sugar 6 in S52°E 29 lks

County surveyor notes

May 02, 1888
NE Cor Sec 18
B. 12 N12.5°W 18
Sugar 6 S52° E 23
B-5 to C-5, 40ch (2640')

Unrecorded Survey

K. VanOrder Dec. 20, 1988
NE cor Sec 18
FD 3/4" steel rod
r.r. tie cor. Post NE, 42.30'
10" pin cherry SE, 49.55'
power pole SW, 36.98'
USGS #0158 BM SW, 38.55'

Unrecorded Survey

K. VanOrder 03/24/89
Found 1/2" steel rod
Same witness's as 12,20,,1988 survey.

Witness sheet-Holland Eng.

(no date) Fd steel bar
PP SW, 36.30'
USGS BM 0158 SW, 38.40'
St. sign NE, 36.80'
6" Cherry SE, 49.70'
set iron
same ties as above, no cherry

County Witness Card

(no date) NW cor sec 17
PP SW, 36.30'
BM USGS 0158 SW 38.40'
St. sign NE 36.80'

County Witness Card

(no date) NE cor sec 18
PP SW, 36.30'
BM USGS 0158 SW 38.40'
Street sign S

LIBERO 007 PAGED 70