

REMONUMENTATION

APR 07 1998

Allegan County Remonumentation
LAND CORNER RECORDATION CERTIFICATE
Filing Requirement of Act 74, Mich. P.A. 1970

SECTION

For corners in
Allegan
(County)

Located In: Corner Code #

- 1. Public Land Survey T 4N R 13W D-1 (N1, 5)
T ___ R ___ Salem Twp.
T ___ R ___
T ___ R ___
- 2. Property Controlling in Section S ___ T ___ R ___
S ___ T ___ R ___
- 3. Miscellaneous Property in Sec. S ___ T ___ R ___
S ___ T ___ R ___

- 4. Lot No. _____, Recorded Plat _____
- 5. Private Claims _____

John C. Bueche
REGISTER OF DEEDS
ALLEGAN COUNTY, MICH.

98 JAN 21 PM 1:35

FILED

Register of Deeds Stamp & File Number

I, John C. Bueche, in a field survey on April 15, 19 97, do hereby certify that under requirements of P.A. 74, Michigan P.A. of 1970, the corner points mentioned in lines 1 and 2 above were in conformance with regulations and rules therefore as required in the current manual of survey instructions of the United States Department of the Interior, Bureau of Land Management or by a decree of a Court of Law and/or that the corner points mentioned in lines 3, 4 and 5 above were in conformance with the rules of the Michigan Board of Land Surveyors or by a Decree of a Court of Law; established, re-established, monumented, re-monumented, recovered, found as expressed below:

NOTE: Not more than 4 corners, all in the same town and range, may be recorded on this certificate.

	A	B	C	D	E	F	G	H	I	J	K	L	M
2	6	5	4	3	2	1							
3													
4	7	8	9	10	11	12							
5													
6	16	17	18	19	20	21	22	23	24				
7													
8	19	20	21	22	23	24							
9													
10	30	29	28	27	26	25							
11													
12	31	32	33	34	35	36							
13													

A. Description of original monument and accessories and/or subsequent restoration:

D-1 GLO CP Co. 1976
 Not set Meas. W from S 1/4 32, 5-13
 2652.11' to NW 5
 Meas. E from S 1/4 32, 5-13
 2619.11' to NE 5
 No cor. found or set
 Jog 38.01' E of S 1/4 32

B. Description of corner evidence found and/or method applied in restoring or reestablishing corner:

D-1 Found N/A capped rerod on South line Twp. to the North 1' South
 of E-W fence
 Meas. West to NW 5 2652.28' (CP Co. 2652.11')
 Meas. East to NE 5 2651.49' (CP Co. 2651.11')
 Fence North from Ottawa corner
 No occupation South

APPROVED REMONUMENTATION CORNER
 P.A. 345 OF 1990
 ALLEGAN COUNTY
 DATE APPROVED 5-13-97
 COUNTY REP. K.V.O.

This position not established by original government surveyors.
This monument is accepted as the best available evidence of the position of the corner.


Traverse D-13 to E-13 2655.83'
See sketch on back

Peer group approved May 13, 1997.


C. Description of monument for corner and accessories established to perpetuate locating the position of the corner:

D-1 Replaced rerod with Allegan Co. Mon. (3/4" x 36" pin with cap)
 Nail & Allegan Co. Remon. Tag in S side 24" Elm S 80° E 10.84'
 Nail & Allegan Co. Remon. Tag in SE side 12" Elm S 10° W 4.45'
 Nail & Allegan Co. Remon. Tag in W side 8" Elm S 40° E 30.90'
 Nail & Allegan Co. Remon. Tag in E side 4" Elm S 30° W 25.65'
 E-W fence North 1'±
 Ottawa Co. Mon. S 1/4 32, 5-13 West 37.28' @ fence cor.

Signed by John C. Bueche Date 7-3-97
Surveyor's Michigan License No. 13027

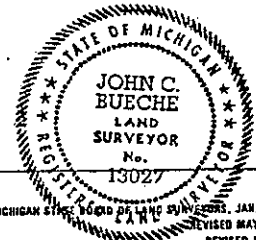

FORM APPROVED BY MICHIGAN BOARD OF LAND SURVEYORS, JAN. 28, 1971
REVISED MAY 14, 1975
REVISED JAN., 1993

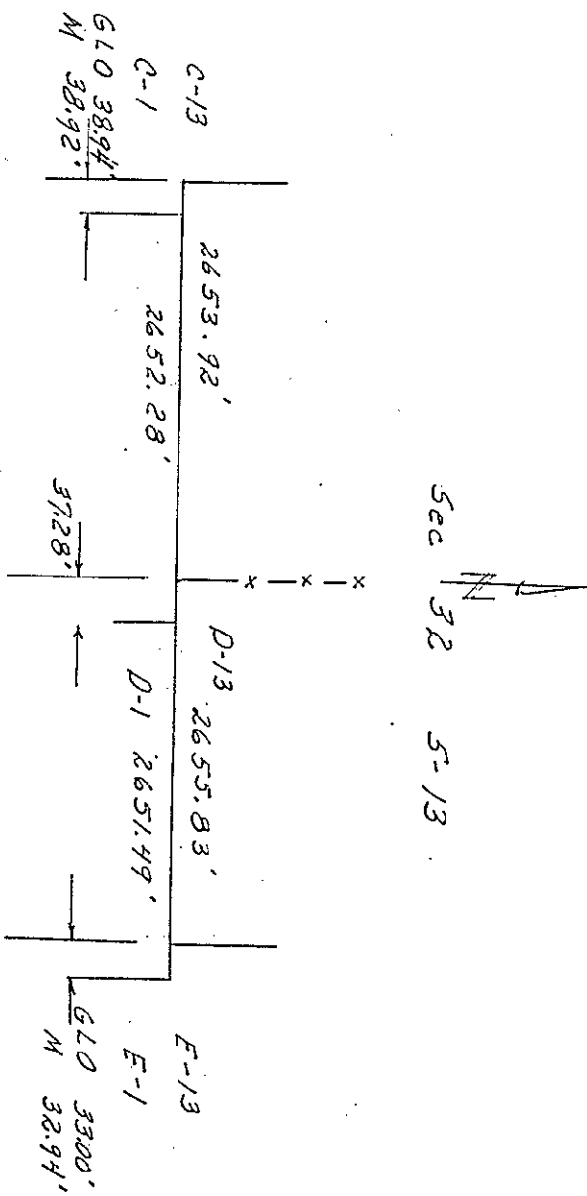

CORRECTED
 BY: [illegible]
 DATE: [illegible]
 CHECKED BY: [illegible]
 DATE: [illegible]