APR 0 7 1998


SECTION	Allegan LAND COR	County Remonus	mentation CERTIFICATE			
F		irement of Act 74, M		. 20	98	
For corners in	•	·	,	Emoti		
Allegan Icounty	Located In:	Corner Code =#	*	500	JAN	T]
Public Land Survey	T <u>4N</u> R 13W T R T R	Salem Twp.		Condition of the condit	21 Pil	
Property Controlling in Section Miscellaneous Property in Sec.	S T R S T R S T R S T R			ister of Deeds Stan	ာ မေ ကp & File No	umber
4. Lot No, Re	corded Plat			4 9 C D E		
5. Private Claims John C. Busche do hereby certify that under required in lines 1 and 2 above were in a current manual of survey instruction of Law; established, respectively. NOTE: Not more than 4 coron this certificate.	in a field survey on _Apri irements of P.A. 74, Michigan P. conformance with regulations - tions of the United States Dep Court of Law and/or that the con- the rules of the Michigan Board established, monumented, re	1 15	9 97	A B C O E 1	F G M I	J K L h
E-1 GLO 1831 Lucius Lyon, D Intersected N boundary 50 lks. East of post (33.0	Nothing foun	d or set	West 33.1 Harrison N 30° W fnd. N 62° E (side UP	Aug., 1996 00' SW cor. n Mon. 126.71' SE c	cor. gá PK in S	ir E
Description of corner evid	Lence found and/or method	l applied in restoring or				
Meas. West to I Meas. East to I	rerod on South N 1/4 5 2651.49' N 1/4 4 2667.09'	(CP Co. 2652. (CP Co. 2666.	As pér at 11') 22')	bove witness		
And is accepted of the original	d as a careful a al corner.	nd faithful pe	rpetuation	n of the pos	ition	
			E-13 to F ch on back	F-13 2624.53 K	3 '	
Peer group approv	red May 13, 1997.					
E-1 Replaced 1, (4" below grad Nail & Ottawa (NE cor. conc. p SW cor. brick ton C/L gravel (On C/L gravel (Ottawa Co. Mon.	Co. Remon. Tag in Corch N 50° W 126 ise. N 25° E 141 coad South extend	llegan Co. Mon S side PP N in N side PP N N Side 18" P n N side Maple 5.77' .78' ded North	62° E 64.9 75° W 58.	x 24" pin wi 97' .23' E 62.56' 70° W 125.22	th cap	

UETR 0006 PAGE 209

Sheet I of 2

APTROVED ST MIC

CHANGE THE S. JAN. 28, 187

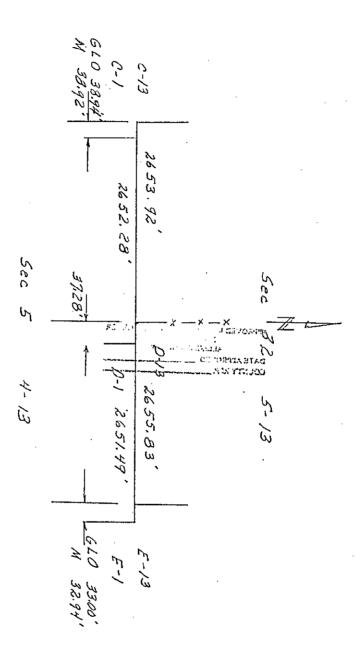

Sheet 2 of 2