

**Allegan County Remonumentation
LAND CORNER RECORDATION CERTIFICATE**
Filing Requirement of Act 74, Mich. P.A. 1970


For corners in
Allegan
(County)

	Located In:	Corner Code #
1. Public Land Survey	T <u>4N</u> R <u>13W</u>	<u>E-12(S 1/4, 32)</u>
	T _____ R _____	<u>Salem Twp.</u>
	T _____ R _____	_____
	T _____ R _____	_____
2. Property Controlling in Section	S _____ T _____ R _____	_____
	S _____ T _____ R _____	_____
3. Miscellaneous Property in Sec.	S _____ T _____ R _____	_____
	S _____ T _____ R _____	_____

1993 DEC 17 PM 1:56
REGISTER OF DEEDS
ALLEGAN COUNTY, MICHIGAN
John C. Bueche
Register of Deeds Stamp & File Number
FILED

4. Lot No. _____, Recorded Plat _____
5. Private Claims _____

I, John C. Bueche, in a field survey on October 26, 1993, do hereby certify that under requirements of P.A. 74, Michigan P.A. of 1970, the corner points mentioned in lines 1 and 2 above were in conformance with regulations and rules therefore as required in the current manual of survey instructions of the United States Department of the Interior, Bureau of Land Management or by a decree of a Court of Law and/or that the corner points mentioned in lines 3, 4 and 5 above were in conformance with the rules of the Michigan Board of Land Surveyors or by a Decree of a Court of Law, established, re-established, monumented, re-monumented, recovered, found as expressed below:

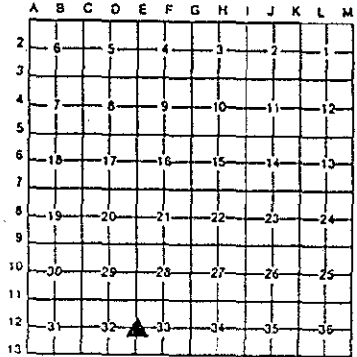

NOTE: Not more than 4 corners, all in the same town and range, may be recorded on this certificate.


- A. Description of original monument and accessories and/or subsequent restoration:
- | | | | |
|--------------------|-------------------|-----------------------|----------------------|
| E-12 Ratekin, 1968 | Ratekin, 1978 | LCRC L2, P36, 9-28-72 | LCRC L2, P93, 5-8-73 |
| Iron N-S fence | what is there | Iron | 1" iron bar |
| E-W fence N 3.0' | 10" B. Oak | 8" B. Oak | SE 25.20' 16" Oak |
| Quad. Maple | S 85° W 33.53' | W 33.6' | SW 37.05' 12" Oak |
| NNW 17.5' | 16" B. Oak | 14" B. Oak | NW 42.2' 20" Oak |
| Nail 18" tree | N 50° W 41.23' | N 45° W 41.3' | |
| 18.0' | 14" W. Oak | 12" W. Oak | ESE 24.7' |
| 18" Hickory | S 60° E 24.80' | | See back |
| NE 47.7' | 1/2 iron with cap | E 33' | |

- B. Description of corner evidence found and/or method applied in restoring or reestablishing corner:
- E-12 Found 1/2" capped rerod #30075 as per wit. date 3-99-92 before construction
- PK S side 8" Oak ENE 45.71'
 - PK N side 12" Oak NW 67.94'
 - PK SW side 30" Oak NW 42.05'
 - PK N side 14" Oak E 51.42'
 - PK E side 16" Oak SE 25.72'

And is accepted as a careful and faithful perpetuation of the position of the original corner.

- C. Description of monument for corner and accessories established to perpetuate locating the position of the corner:
- E-12 Replaced 1/2" rerod with Std. Allegan Co. Mon. (3/4" x 24" Pin & Cap), down 6"
- Conc. Nail & Allegan Co. Remon. Tag in S side 8" Oak N 70° E 45.74'
 - Conc. Nail & Allegan Co. Remon. Tag in N side 24" Oak S 85° E 51.15'
 - Conc. Nail & Allegan Co. Remon. Tag in W side dbl. 12" Oak S 40° E 92.65'
 - Conc. Nail & Allegan Co. Remon. Tag in E side dbl. 8" Oak S 30° W 83.25'
 - Conc. Nail & Allegan Co. Remon. Tag in N side 12" Oak N 60° W 67.77'
- On C/L gravel road N-S
No field divisions E-W
Meas. by hand

Signed by John C. Bueche Date Oct 26, 1993
Surveyor's Michigan License No. 13027

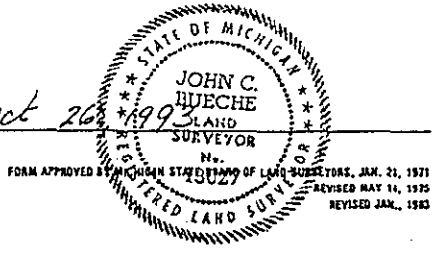

Wightman Moored
1" iron, 3-9-92
PK S side 8" Oak ENE 45.71'
PK N side 12" Oak NW 67.94'
PK SW side 30" Oak NW 42.05'
PK N side 14" Oak E 51.42'
PK E side 16" Oak SE 25.72'
C/L road 8'± W (gravel)