
	SECTION	A 1 1 LA N	egan Co ID CORNE	Bunty Remonum R RECORDATION (nentation CERTIFICATE	8	98	
F	or corners in			ment of Act 74, Mi		Eg d		-71 1.
_	Allegan (County)	Located in	n:	Corner Code ≠≠		SE CE	JAN 21	TIT
Ť.	Public Land Survey	Т	R	F-1 (N; 4) Salem Twp.	_	? Estato HTC-404	PN 1: 36	U D
2.	Property Controlling in Section	\$T	R			•	0.	
3.	Miscellaneous	S T S T	R		 	t-1- 4 n 1		
	Property in Sec.	s T	R		_ !	ister of Deeds Star	np & File N	lumber
4.	Lot No.	. Recorded Plat	P.A	ONUMENTATION CORN L 345 OF 1990	IER.			
5.	Private Claims		ALL. TEAPPROVE	EGAN COUNTY D5-73-9	7	A B C D E	FGHI	JKL
			UNTY REP	K. V. O.		3 5 5	i — - -	- <u>-</u>
in cu Ma ab	nereby certify that under lines 1 and 2 above were trent manual of survey in magement or by a decrea ove were in conformance	, in a field survey on requirements of P.A. 74, M re in conformance with reg instructions of the United Size of a Court of Law and/or the with the rules of the Michid, re-established, monum	chiganP.A. o utations and ates Departo at the corner gan Board of	f 1970, the corner points rules therefore as requirent of the Interior, Bure points mentioned in line I and Surgeyors or by a line.	mentioned pired in the eau of Land is 3, 4 and 5	4 7 8 5 5 6 18 17 17 17 8 19 19 19 19 19 19 19 19 19 19 19 19 19	6-15-1-1-22-1-1-22-1-1-1-22-1-1-1-1-1-1-1	-11 - 12 - 1314 - 132324
		4 corners, all in the san	ne town and	range, may be reco	rded	10 30 29 2	8-27-	-2625
	on this certifica	ite.		, , ,		12 -31 -32 -3	3-34	-3536
A.	Description of origin	al monument and acces	sories and/	or subsequent restor	ation:	13		
8.	Not set CP Sho Not NW S S 4	rd dist. West of Co. L882, P66; Dw 74.63' E. of thing set 4 to S 1/4 33 1/4 33, 5-13 to 10° E 53.15' set Pine 40° W 47.08' set of evidence found and/or	2, Mar. f S 1/4 , 5-13 : o NE 4 : ot PK N	, 1976 33, 5-13 2591.59' 2742.86' E side W side 42" Ma	Set 1/2" Equidistance A. 4. 4. 4. 4. 4. 4. 4. 4. 4. 4. 4. 4. 4.	rod with cant from NW -13 on line 3, 5-13 & SI 51'S 1/4 33 41.10' set Fe	4, 4-1 betwee 33, 5	3 & en 5−13
U.		•			_			
	South, on C	<pre>/2" capped rero C/L gravel road</pre>	od on So I E-W	outh line Twr				
					N 10° E A	51'S 1/4 33 41.10'PK W	s, 5-13 side	: ·
	Meas. East N This position	W 4 2667.09' (E 4 2667.36' (on not establis it is accepted eer.	CP Co.	2668.22')	ernment s le evider	surveyors. nce of the p	ositio	'n
	Peer group app	roved May 13, 199	7.	Traverse See sketc		-13 2659.32 <	·*	
C.	r-1 Replaced with cap)	nent for corner and accell 1/2" capped ran Co. Remon.	erod wi	ith Allegan C	o. Mon. (3/4" x 24"	pin	
	N 63° E 86. Nail & Alleg	an Co. Remon. 49' an Co. Remon.	lag in	SE side 8" O)ak (5° ab k N 10° F	ove ground) : An aa;	90,90	•
	Nail & Alleg Nail & Alleg On C/L grave	an Co. Remon. an Co. Remon. 1 road E-W; on emon. (S 1/4 3	Tag in Tag in fence	SW side 8" O N side 12" M South	ak N 50° aple S 70	W 75 161	Authorite Karlin	
Sic-		,	Bueck	4		* JOHN C	1	
	John C. Bu eyor's Michigan Licen		pueur	Date	<u> 7-3-97</u>	SURVEYOR	**	
•		0006 _{PAGE} 211	s	heet 1 of 2	FORM APPROVED	ATHER STATE SHIP OF LAND	r ,√EYE	13, JAN, 28, 1971 EO MAY 14, 1975 VISED JAH,, 1981

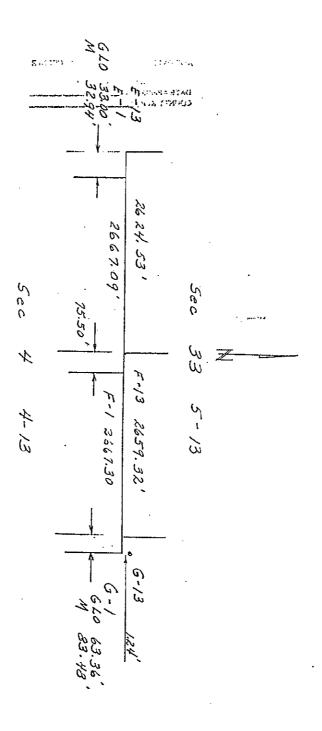

Sheet 2 of 2