

APR 29 1998

SECTION

Allegan County Remonumentation
LAND CORNER RECORDATION CERTIFICATE
Filing Requirement of Act 74, Mich. P.A. 1970

For corners in

<u>Allegan</u> (County)	Located In:	Corner Code #
1. Public Land Survey	T <u>4N</u> R <u>13W</u>	G-13 (SE, 33)
	T _____ R _____	Salem Twp.
	T _____ R _____	_____
	T _____ R _____	_____
2. Property Controlling in Section	S _____ T _____ R _____	_____
	S _____ T _____ R _____	_____
3. Miscellaneous Property in Sec.	S _____ T _____ R _____	_____
	S _____ T _____ R _____	_____

FILED

1/28/1999 2:44:39 PM

JOYCE A. WATTS
REGISTER OF DEEDS
ALLEGAN COUNTY, MICH

Register of Deeds Stamp & File Number

- 4. Lot No. _____, Recorded Plat _____
- 5. Private Claims _____

I, John C. Bueche, in a field survey on April 13, 19 98, do hereby certify that under requirements of P.A. 74, Michigan P.A. of 1970, the corner points mentioned in lines 1 and 2 above were in conformance with regulations and rules therefore as required in the current manual of survey instructions of the United States Department of the Interior, Bureau of Land Management or by a decree of a Court of Law and/or that the corner points mentioned in lines 3, 4 and 5 above were in conformance with the rules of the Michigan Board of Land Surveyors or by a Decree of a Court of Law; established, re-established, monumented, re-monumented, recovered, found as expressed below:

NOTE: Not more than 4 corners, all in the same town and range, may be recorded on this certificate.

A	B	C	D	E	F	G	H	I	J	K	L
2	6	5	4	3	2	1					
3											
4	7	8	9	10	11	12					
5											
6	13	17	16	15	14	13					
7											
8	19	20	21	22	23	24					
9											
10	30	29	28	27	26	25					
11											
12	31	32	33	34	35	36					
13											

A. Description of original monument and accessories and/or subsequent restoration:

G-13 GLO, 1831	Survey 6-15-92 VanOrder	LCRC 2-36, Sept., 1972 Ratekin
Lucius Lyon, DS	Fnd. 1" iron in Mon. Box	1" iron
Set post cor.	Nail NW side PP NE 104.12'	12" Shag Hick. S 15.50'
secs. 33 & 34	Nail NW side 28" Blue Ash	30" Pig Nut NNE 38.70'
Maple 16" N 16 W 34	NE 168.08'	PP SE 65.50'
W. Oak 18" N 30 E 63	C/L top tele. pedestal	Stone
	SE 63.80'	12" Pig Nut NE 39.40'
	C/L top tele. pedestal	6" Shag bark S 16.00'
	SW 81.70'	4" Walnut NW 74.40'

B. Description of corner evidence found and/or method applied in restoring or reestablishing corner:

Monterey cor. W. 56.80'


G-13 Found 1" iron in Mon. Box C/L bit. road E-W; on C/L bit. road N, road extended South
 28" Blue Ash NE 168.08'± Monterey cor. W. 56.80'
 C/L top tele. pedestal
 SE 63.80'±
 C/L top tele. pedestal
 SW 81.70'±

And is accepted as a careful and faithful perpetuation of the position of the original corner.

C. Description of monument for corner and accessories established to perpetuate locating the position of the corner:

G-13 Replaced 1" iron with 3/4" x 24" Pin with Allegan Co. Cap in Mon. Box
 Dbl. headed Nail in N side 30" Blue Ash N 53° E 168.14'
 Nail & Allegan Co. Remon. Tag in N side 14" Elm S 75° E 137.08'
 Nail & Allegan Co. Remon. Tag in W side 12" Elm S 40° E 68.22'
 Nail & Allegan Co. Remon. Tag in W side UP S 03° W 115.21'
 NE cor. siding S 63° W 176.16'
 On C/L bit. road E-W; on C/L bit. road N. extended South; C/L bit. road N-S is West 24"
 Allegan Co. Mon. in Mon. Box (NE 4, 3-13) West 56.95'

APPROVED REMONUMENTATION CORNER
 P.A. 345 OF 1990
 ALLEGAN COUNTY
 DATE APPROVED MAY 12, 1998
 COUNTY REP. [Signature]

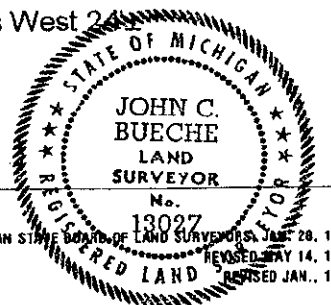

Signed by John C. Bueche
 Surveyor's Michigan License No. 13027

Date 5-8-98