
APR 0 7 1998

	SECTION	LAN	CORNER	RECORDATION C	ERTIFICATE	. %	82	
F۸	r corners in	Filing	g Requiren	ent of Act 74, Mic	h. P.A. 1970	ર્ટ્સ કુલ <i>્દ્ર</i> ે		
. •	Allegan	1 page of lev		C	!	\$ 25	JAN	η
_	(County)	Located In:	•	Corner Code ##		5E 7	2 [一
1.	Public Land Survey	T <u>4N</u> F T F T F	}	H-1 (N1, 3) Salem Twp.	-	A PURE NAME OF THE PARTY OF THE	PH 1:	m O
	Property Controlling in Section	S T F S T F			- - -		36	
3.	Miscellaneous Property in Sec.	S T R S T R			Regis	ster of Deeds Stam	p & File Nu	mber
	, ,				· · · · · · · · · · · · · · · · · · ·			
	Lot No , i					ABCDEF	виг.	Ј К L М
J.	Private Claims					3 5 4	13-	2
in li cur Mar abo	John C. Bueche herebycerlify that under re ines 1 and 2 above were it rent manual of survey instragement or by a decree of we were in conformance with the c	quirements of P.A. 74, Mic n conformance with regu uctions of the United Sta a Court of Law and/or tha ith the rules of the Michig	thigan P.A. of the plant of the corner plant of the corner plant of L. and o	1970, the corner points rules therefore as requient of the Interior, Buresonts mentioned in lines and Surveyors or by a D	nentioned red in the au of Land 3, 4 and 5 ecree of a found as	4 7 8 9 5 6 18 17 16 7 8 19 20 21 9 10 10 23 28	15 1	112
	TE: Not more than 4 c		e town and	range, may be recon	ded 1	30 29 26	272	6
Α	Description of original	monument and access	oriae and/o	r subsequent restors		3		لتلا
	H-1 GLO			•		Dace		
	Not set	CP Co. L Mar., 1 2629.89' 2629.89'	976 W to N	W cor.	dist. of	P362 on line & sec. line N 65° W 46.	•	
		NE cor.	is 43.5	6' E of	PP S 10° 22" Osage	E 40.50' Orange N 7	o °	
		NW cor. SW 34,	is 83.4 5-13 (G	LO is 63.36')	ROVED REMONUMENT P.A. 345 OF IT ALLEGAN COL E APPROVED	990 INTY	ŒR
В.	Description of corner e	vidence found and/or	method app	lied in restoring or re	establishin	WIY REP.	V. V. O.	<u> </u>
	H-1 Found cap road 1' S. o No occupation Meas. West NW Meas. East NE	f C/L South 3 2629.11'(CP Co.	2629,89')	to the No As per ab		vel	•
	This position This monument of the corne	is accepted	hed by as the	original gov best availab	ernment s le eviden	urveyors. ce of the p	osition	
			٠	Traverse See sketc		-13 2639.42	,	
Э.	Peer group appro Description of monume H-1 Replaced cap) on South Nail CP tag i Nail CP tag i Nail & Allega Nail & Allega C/L gravel ro Ottawa Co. Mo	ntior corner and acce capped rerod line of Twp. n SW side PP n NE side PP n Co. Remon. n Co. Remon. ad E-W North	ssories este with Al to the S 20° E N 60° W Tag in Tag in 1'+	legan Co. Mo North 40.51' 46.53' S side 32" O NE side 6" M	n. (3/4" sage Oran aple N 40	x 24" pin w ge N 70° W ° W 87.91' ne North)	ith	
ign	ed by	John	C Buec	he Date	1-3-97	* JOH * BUE	N C. CHE *	
	eyor's Michigan License	//	•	-	FORM APPROVED	% 5 à N	EYOR	£
	-	0006 _{PAGE} 215	Sh	neet 1 of 2	FURM AFTAUTÉU :	A NICKION STATE SOUNDS	HD SUPERING	PAR. 28, 1971 FMAY 14, 1975 IED JAK., 1983
					•		1.	

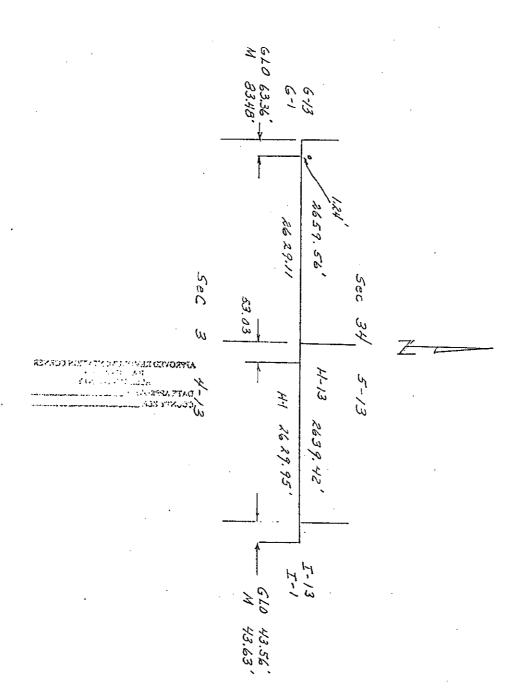

Sheet 2 of 2