

**SURVEY
REMONUMENTATION**

APR 29 1998

SECTION

**Allegan County Remonumentation
LAND CORNER RECORDATION CERTIFICATE
Filing Requirement of Act 74, Mich. P.A. 1970**

FILED

For corners in

<u>Allegan</u> (County)	Located In:	Corner Code ##
1. Public Land Survey	T 4N R 13W	H-13 (S $\frac{1}{4}$, 34)
	T _____ R _____	Salem Twp.
	T _____ R _____	_____
	T _____ R _____	_____
2. Property Controlling in Section	S _____ T _____ R _____	_____
	S _____ T _____ R _____	_____
3. Miscellaneous Property in Sec.	S _____ T _____ R _____	_____
	S _____ T _____ R _____	_____

1/28/1999 2:44:39 PM

JOYCE A. WATTS
REGISTER OF DEEDS
ALLEGAN COUNTY, MICH

Register of Deeds Stamp & File Number

4. Lot No. _____, Recorded Plat _____
5. Private Claims _____

	A	B	C	D	E	F	G	H	I	J	K	L	M
2	6		5		4		3		2		1		
3													
4	7		8		9		10		11		12		
5													
6	18		17		16		15		14		13		
7													
8	19		20		21		22		23		24		
9													
10	30		29		28		27		26		25		
11													
12	31		32		33		34		35		36		
13													

I, John C. Bueche, in a field survey on April 13, 19 98, do hereby certify that under requirements of P.A. 74, Michigan P.A. of 1970, the corner points mentioned in lines 1 and 2 above were in conformance with regulations and rules therefore as required in the current manual of survey instructions of the United States Department of the Interior, Bureau of Land Management or by a decree of a Court of Law and/or that the corner points mentioned in lines 3, 4 and 5 above were in conformance with the rules of the Michigan Board of Land Surveyors or by a Decree of a Court of Law; established, re-established, monumented, re-monumented, recovered, found as expressed below:

NOTE: Not more than 4 corners, all in the same town and range, may be recorded on this certificate.

A. Description of original monument and accessories and/or subsequent restoration:

H-13 GLO, 1831	Survey L1099, P774, 1/1985 Tri County
Lucius Lyon, DS	Survey L1061, P273, 5/1983 Jonker
Set quarter sec. post	HEI inform. sheet
Beech 18 N 40	1/2" rod
E 8	Nail in side 30" Maple SW 45.58'
Beech 17 N 53	Nail in side 12" Ash ENE 64.90'
W 47	Nail in side 36" Maple N 67.04'
	Iron W. 35.60'

LCRC 2-391, July, 1975
Bonnema
Same wit. as left

B. Description of corner evidence found and/or method applied in restoring or reestablishing corner:


H-13 Found 1/2" x 12" rerod in Mon. Box; on C/L bit. road E-W; on fence N.; C/L gravel road S. is W. 42'±
36" Maple N 67.04'
Iron W 35.60'

And is accepted as a careful and faithful perpetuation of the position of the original corner.

APPROVED REMONUMENTATION CORNER
P.A. 345 OF 1990
ALLEGAN COUNTY
DATE APPROVED MAY 12, 1998
COUNTY REP. [Signature]

C. Description of monument for corner and accessories established to perpetuate locating the position of the corner:

H-13 Replaced 1/2" rerod with 3/4" x 24" Pin with Allegan Co. Cap in Mon. Box
Nail & Allegan Co. Remon. Tag in SW side 10" Elm S 40° E 53.13'
Nail & Allegan Co. Remon. Tag in W side PP S 00° E 41.98'
Nail & Allegan Co. Remon. Tag in E side 26" Elm S 45° W 115.18'
Nail & Allegan Co. Remon. Tag in W side 40" Maple N 00° E 67.10'
Nail & Allegan Co. Remon. Tag in N side 10" Oak S 70° E 113.99'
On C/L bit. road E-W; on fence N.; C/L gravel road S. is W. 42'±
Allegan Co. Mon. H-1 (N $\frac{1}{4}$ 3, 3-13) West 35.60'

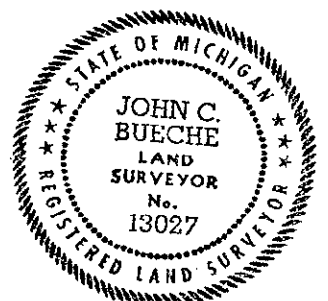

Signed by John C. Bueche
John C. Bueche, P.S. 13027
Surveyor's Michigan License No.

Date 5-8-98