

REMONUMENTATION

APR 07 1998

SECTION

Allegan County Remonumentation  
LAND CORNER RECORDATION CERTIFICATE  
Filing Requirement of Act 74, Mich. P.A. 1970

For corners in

Allegan  
(County)

Located In:

Corner Code ##

- 1. Public Land Survey T 4N R 13W I-1 (NE, 3)  
T \_\_\_\_\_ R \_\_\_\_\_ Salem Twp.  
T \_\_\_\_\_ R \_\_\_\_\_  
T \_\_\_\_\_ R \_\_\_\_\_
- 2. Property Controlling S \_\_\_\_\_ T \_\_\_\_\_ R \_\_\_\_\_  
in Section S \_\_\_\_\_ T \_\_\_\_\_ R \_\_\_\_\_
- 3. Miscellaneous S \_\_\_\_\_ T \_\_\_\_\_ R \_\_\_\_\_  
Property in Sec. S \_\_\_\_\_ T \_\_\_\_\_ R \_\_\_\_\_

*James A. Bueche*  
REGISTER OF DEEDS  
ALLEGAN COUNTY, MICH.


98 JAN 21 PM 1:36

FILED

Register of Deeds Stamp & File Number

- 4. Lot No. \_\_\_\_\_, Recorded Plat: \_\_\_\_\_
- 5. Private Claims \_\_\_\_\_

I, John C. Bueche, in a field survey on April 15, 19 97, do hereby certify that under requirements of P.A. 74, Michigan P.A. of 1970, the corner points mentioned in lines 1 and 2 above were in conformance with regulations and rules theretore as required in the current manual of survey instructions of the United States Department of the Interior, Bureau of Land Management or by a decree of a Court of Law and/or that the corner points mentioned in lines 3, 4 and 5 above were in conformance with the rules of the Michigan Board of Land Surveyors or by a Decree of a Court of Law, established, re-established, monumented, re-monumented, recovered, found as expressed below:

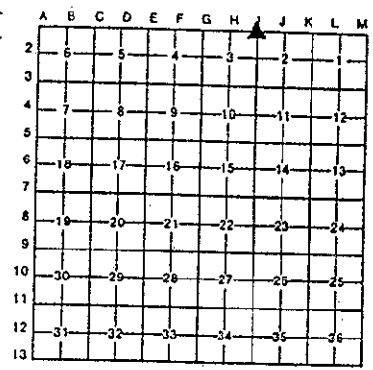

NOTE: Not more than 4 corners, all in the same town and range, may be recorded on this certificate.

A. Description of original monument and accessories and/or subsequent restoration:

I-1 GLO, 1831	CP Co. L882, P658	LCRC L2, P362, Jan., 1975
Lucius Lyon, DS	From NE 3 West to N 1/4 3 2629.89'	Set rerod gov't. dist. from SE cor. 34, 5-13
To N. boundary 66 lks.	From NE 3 East to S 1/4 35, 5-13	Road sign N 40° W 34.85'
E. of post (43.56')	2595.11'	Iron West 43.56'
Beech 6 S 58 E 24 lks.	Show 43.56' jog	
Beech 7 S 82 W 28 lks.		

APPROVED REMONUMENTATION CORNER  
P.A. 345 OF 1990  
ALLEGAN COUNTY  
DATE APPROVED 5-13-97  
COUNTY REP. E.V.O.

B. Description of corner evidence found and/or method applied in restoring or reestablishing corner:

I-1 Found 1/2" rerod on South line Twp. to the North  
Ottawa Co. Mon. West 43.63'  
Meas. W. to N 1/4 3 2629.95' (CP Co. 2629.89')  
Meas. E to N 1/4 2 2618.01' (CP Co. 2623.23' they had 28.19' jog, it is now 21.78')

And is accepted as a careful and perpetuation of the position of the original corner.


Traverse I-13 to J-13 2639.86'  
See sketch on back

Peer group approved May 13, 1997.

C. Description of monument for corner and accessories established to perpetuate locating the position of the corner:

- I-1 Replaced 1/2" rerod with Allegan Co. Mon. (3/4" x 24" pin with cap)
- Nail & Ottawa Co. Remon. Tag in N side 22" Elm S 02° W 17.54'
- Nail & Allegan Co. Remon. Tag in SW side 8" Elm S 65° E 41.19'
- Nail & Ottawa Co. Remon. Tag in SE side PP N 59° E 132.76'
- Nail & Ottawa Co. Remon. Tag in W side PP N 18° W 71.70'
- Nail & Ottawa Co. Remon. Tag in S side PP N 70° W 183.94'
- Ottawa Co. Mon. (SE 34, 5-13) West 43.63'
- C/L gravel E-W North 3'±, C/L gravel North West 43'±

Signed by John C. Bueche Date 7-3-97  
Surveyor's Michigan License No. 13027

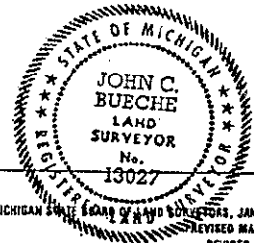

FORM APPROVED BY MICHIGAN STATE BOARD OF LAND SURVEYORS, JAN. 29, 1971  
REVISED MAY 14, 1975  
REVISED JAN., 1983

