

**SURVEY  
REMONUMENTATION**

APR 29 1998

**SECTION**

Allegan County Remonumentation  
**LAND CORNER RECORDATION CERTIFICATE**  
Filing Requirement of Act 74, Mich. P.A. 1970

For corners in

Allegan  
(County)

Located In:

Corner Code #

1. Public Land Survey	T	4N	R	13W	I-13 (SE, 34)
	T		R		Salem Twp.
	T		R		
	T		R		
2. Property Controlling in Section	S		T	R	
	S		T	R	
3. Miscellaneous Property in Sec.	S		T	R	
	S		T	R	

FILED

1/28/1999 2:44:39 PM

JOYCE A. WATTS  
REGISTER OF DEEDS  
ALLEGAN COUNTY, MICH

Register of Deeds Stamp & File Number

4. Lot No. \_\_\_\_\_, Recorded Plat \_\_\_\_\_  
5. Private Claims \_\_\_\_\_

I, John C. Bueche, in a field survey on April 13, 1998 do hereby state that under requirements of P.A. 74, Michigan P.A. of 1970, the corner points mentioned in lines 1 and 2 above were in conformance with regulations and rules therefore as required in the current manual of survey instructions of the United States Department of the Interior, Bureau of Land Management or by a decree of a Court of Law and/or that the corner points mentioned in lines 3, 4 and 5 above were in conformance with the rules of the Michigan Board of Land Surveyors or by a Decree of a Court of Law; established, re-established, monumented, recovered, found as expressed below:

NOTE: Not more than 2 corners, all in the same town and range, may be recorded on this certificate.

	A	B	C	D	E	F	G	H	I	J	K	L	M
1													
2		6		5		4		3		2		1	
3													
4		7		8		9		10		11		12	
5													
6		18		17		16		15		14		13	
7													
8		19		20		21		22		23		24	
9													
10		30		29		28		27		26		25	
11													
12		31		32		33		34		35		36	
13													

A. Description of original monument and accessories and/or subsequent restoration:

I-13 GLO, 1831	LCRC 1-160, Nov., 1971 Bonnera	Survey 992-752 MVK
Lucius Lyon, DS	Re-established obliterated cor. by	Wit. same as LCRC 1-160
Set post cor. secs. 34 & 35	existing evidence	Survey 1061-274 Jonker 5-83
Beech 10" N 10 E 33	Set 5/8" solid rod	5/8" rerod
Beech 11" N 46 W 42	TP NW 42.55'	1/2" rerod N 45° E 46.86'
	PP SW 66.42'	N. bolt on E. end CMP S 59.08'
	20" W. Cherry NNE 112.46'	C/L gravel W 10' 7 & N 8
	C/L gravel N, West 9'±	
	C/L gravel E-W, North 10'±	

B. Description of corner evidence found and/or method applied in restoring or reestablishing corner:

I-13 Found 1/2" x 24" rerod in Mon. Box; on C/L bit. road N.; on C/L bit. road E-W is N. 2'±  
C/L gravel road S. is West 18  
Wit. gone  
1/2" rerod N 45° E 46.86'  
N. bolt on E. end CMP S 59.08'


And is accepted as a careful and faithful perpetuation of the position of the original corner.

APPROVED REMONUMENTATION CORNER  
P.A. 345 OF 1990  
ALLEGAN COUNTY

DATE APPROVED MAY 12, 1998  
COUNTY REP. [Signature]

C. Description of monument for corner and accessories established to perpetuate locating the position of

I-13 Replaced rerod with 3/4" x 24" Pin with Allegan Co. Cap in Mon. Box  
Nail & Allegan Co. Remon. Tag in W side 12" Elm S 40° W 70.74'  
Nail & Allegan Co. Remon. Tag in N side PP N 80° E 149.51'  
Nail & Allegan Co. Remon. Tag in NW side 12" Elm N 55° E 94.39'  
Nail & Allegan Co. Remon. Tag in S side 12" Cedar N 60° W 93.27'  
SE cor. conc. fnd. to trailer N 20° W 132.82'  
On C/L bit. road E-W; on C/L bit. road N.  
Allegan Co. Mon. I-1 (NE 3, 3-13) West 17.61'

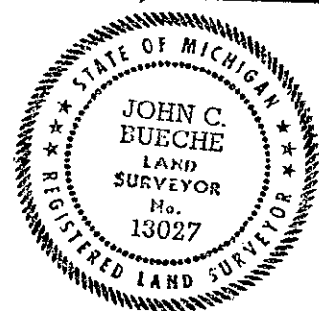

Signed by John C Bueche  
Surveyor's Michigan License No. 13027

Date 5-8-98