

MAR 07 2000

ALLEGAN COUNTY REMONUMENTATION
LAND CORNER RECORDATION CERTIFICATE
Filing Requirement of Act 74, Mich. P.A. 1970

For corners in

SECTION

Allegan (County)	Located in: Salem Twp.	Corner Code #
1. Public Land Survey	T 4N R 13W	J-4
	T R	
	T R	
	T R	
2. Property Controlling in Section	S T R	
	S T R	
3. Miscellaneous Property in Sec.	S T R	
	S T R	

REGISTER OF DEEDS
ALLEGAN COUNTY
James A. ...

00 FEB - 1 AM 8:49

FILED

LIBRARY / P. 28

Register of Deeds Stamp & File Number

4. Lot No. _____, Recorded Plat _____
5. Private Claims _____

I, Robert J Jonker, in a field survey on 10-6, 1998 do hereby state that under requirements of P.A. 74, Michigan P.A. of 1970, the corner points mentioned in lines 1 and 2 above were in conformance with regulations and rules therefore as required in the current manual of survey instructions of the United States Department of the Interior, Bureau of Land Management or by a decree of a Court of Law and /or that the corner points mentioned in lines 3, 4 and 5 above were in conformance with the rules of the Michigan Board of Land Surveyors or by a Decree of a Court of Law; established, re-established, monumented, recovered, found as expressed below:

NOTE: Not more than 2 corners, all in the same town and range, may be recorded on this certificate.

	A	B	C	D	E	F	G	H	I	J	K	L	M
1													
2	6		5		4		3		2		1		
3													
4	7		8		9		10		11		12		
5													
6	18		17		16		15		14		13		
7													
8	19		20		21		22		23		24		
9													
10	30		29		28		27		26		25		
11													
12	31		32		33		34		35		36		
13													

A. Description of original monument and accessories and/or subsequent restoration:

Not set in GLO survey.

PK S. side P. pole W. 34.27'

Nail SW side 20" W. ch. N10°W 122.36'

Nail W side 8" W. ch. S15°E 113.13'

C/L N-S gravel East 5'

C/L E-W pole line, on line

6-6-83

Tri-County Survey

Per Ray Moored

(no info.)

Jonker Land Survey 12-14-99

Check OK

Check OK

Out

Check OK

Check OK

Jonker Land Surveys 5-27-83 Set center at int. of 1/4 lines - took wit. listed above

Jonker - recorded survey Liber 1061, Page 294 same wit. as 5-27-93

B. Description of corner evidence found and/or method applied in restoring or reestablishing corner:

Found rerod per wit. listed in "A" above.

Reset corner with 3/4" x 36" std. Allegan Co. Monument

This position not established by original government surveyors. This monument is accepted as the best available evidence of the position of the corners

Peer group approved 12-14-99

APPROVED REMONUMENTATION CORNER

P.A. 345 OF 1990

ALLEGAN COUNTY

DATE APPROVED

DEC. 14, 1999

COUNTY REP.

[Signature]

C. Description of monument for corner and accessories established to perpetuate locating the position of the corner:

Allegan County Std. monument


PK W side P. pole N86°W 34.21'

Nail & tag W. side 18" W. Cherry N08°W 122.83'

Nail & tag S. side P. pole S86°E 356.48'

NE Corner metal bldg S70°W 175.58'

C/L N-S road is 6' East +-

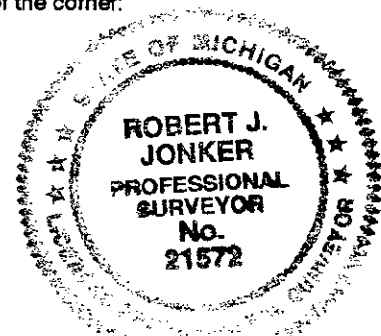

Signed by

Robert J. Jonker

Date

12-10-99

Surveyor's Michigan License No.

21572