

Allegan County Remonumentation  
**LAND CORNER RECORDATION CERTIFICATE**  
 Filing Requirement of Act 74, Mich. P.A. 1970

MAR 16 1994  
 For corners in

Allegan County  
 (County)

Located In: Salem Twp. Corner Code #

- |                                    |                          |             |
|------------------------------------|--------------------------|-------------|
| 1. Public Land Survey              | T <u>4N</u> R <u>13W</u> | <u>K-11</u> |
|                                    | T _____ R _____          | _____       |
|                                    | T _____ R _____          | _____       |
|                                    | T _____ R _____          | _____       |
| 2. Property Controlling in Section | S _____ T _____ R _____  | _____       |
|                                    | S _____ T _____ R _____  | _____       |
| 3. Miscellaneous Property in Sec.  | S _____ T _____ R _____  | _____       |
|                                    | S _____ T _____ R _____  | _____       |


REGISTER OF DEEDS  
 ALLEGAN COUNTY, MICH.  
*James A. Roberts*

1993 DEC 30 PM 2:43

FILED

Register of Deeds Stamp & File Number

4. Lot No. \_\_\_\_\_, Recorded Plat \_\_\_\_\_  
 5. Private Claims \_\_\_\_\_

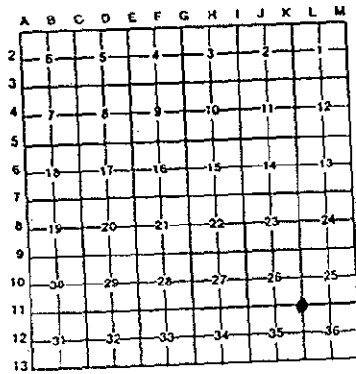

I, Robert Jonker, in a field survey on December 14, 1993, do hereby certify that under requirements of P.A. 74, Michigan P.A. of 1970, the corner points mentioned in lines 1 and 2 above were in conformance with regulations and rules theretofore as required in the current manual of survey instructions of the United States Department of the Interior, Bureau of Land Management or by a decree of a Court of Law and/or that the corner points mentioned in lines 3, 4 and 5 above were in conformance with the rules of the Michigan Board of Land Surveyors or by a Decree of a Court of Law; established, re-established, monumented, re-monumented, recovered, found as expressed below:

NOTE: Not more than 4 corners, all in the same town and range, may be recorded on this certificate.

A. Description of original monument and accessories and/or subsequent restoration:

Original G.O witnesses - post  
 20" W. Oak S 46° E 31 links  
 25" Elm S 48° W 24 links


B. Description of corner evidence found and/or method applied in restoring or reestablishing corner:

Found capped rerod in monbox per wit. from LCRC in L. 003, P. 347.

C. Description of monument for corner and accessories established to perpetuate locating the position of the corner:

Replaced with 3/4"x24" standard capped Allegan Co Monument in mon. box.

Set N & T SW side 12" Maple Az. 126°, 66.24'  
 Fd. Spk. N. side 36" Willow Az. 131°, 42.96'  
 Fd. Spk. NW side 20" Oak Az. 45°, 54.25'  
 Set Spk S'ly side 18" Maple Az. 253°, 77.84'  
 Fd. Spk E. side 15" Willow Az. 222°, 57.30'  
 on C/L N-S pavement & 14'± S. of C'L gravel to East

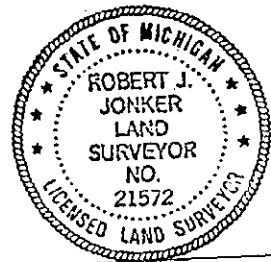

Signed by Robert J. Jonker Date 12-23-93  
 Surveyor's Michigan License No. JONKER LAND SURVEYS 21572

FORM APPROVED BY MICHIGAN STATE BOARD OF LAND SURVEYORS, JAN. 28, 1971  
 REVISED MAY 14, 1975  
 REVISED JAN., 1983

LIBER 004 PAGE 310

Over for Sheet 2

Part "A" continued

Old County Surveyors notes, stake, 1896 & 1897  
 Old County Surveyors notes, Iron, no date

LCRC, Rec. L. 1, P. 185, 1972, Doug Bonnema  
 from Part B

Found iron at L-11 and at the midpoint  
 between L-11 and K-11. Projected this  
 line to K-11 and doubled the distance  
 to set K-11. This seems to check  
 fairly well with center of road to  
 North. The other roads are very crooked.

from Part C

3/4" iron pipe 36" long  
 24" Ash W-SW 2.24'  
 NE corner wign wall on W. side of  
 bridge SW 5.95'  
 NW corner of Easterly wingwall E 28.0'  
 16" Willow NE 53.48'  
 Centerline of gravel road E 9.0'

Jonker Land Surveys, 1982

LCRC, L. 003, P. 347

K-11 Capped Iron

Nail SE side 18" Oak N 40° E 54.27'

Nail NE side 9" Sycamore N 30° W 59.23'

PK N. side 22" Willow S 50° E 43.24'

On C/L N-S gravel & 14' S. of C/L to East

Wightman Moored, 1991, Fd. Capped Iron prior to road reconstruction

Nail N. side 30" Willow SE 43.15'

Nail S. side 9" Elm N 85° W 54.50'

Nail NW side 22" Oak NE 54.35'

C/L road (138th Ave) N 15'±