

**SURVEY  
REMONUMENTATION**

APR 29 1998

Allegan County Remonumentation  
**LAND CORNER RECORDATION CERTIFICATE**  
Filing Requirement of Act 74, Mich. P.A. 1970

**SECTION**

For corners in

<u>Allegan</u> <small>(County)</small>	Located In:	Corner Code #
1. Public Land Survey	T <u>4N</u> R <u>13W</u>	L-9 (N $\frac{1}{2}$ , 25) Salem Twp.
	T _____ R _____	_____
	T _____ R _____	_____
	T _____ R _____	_____
2. Property Controlling in Section	S _____ T _____ R _____	_____
	S _____ T _____ R _____	_____
3. Miscellaneous Property in Sec.	S _____ T _____ R _____	_____
	S _____ T _____ R _____	_____

FILED

1/28/1999 2:44:39 PM


JOYCE A. WATTS  
REGISTER OF DEEDS  
ALLEGAN COUNTY, MICH

Register of Deeds Stamp & File Number

LIBERO 007 PABO 79

4. Lot No. \_\_\_\_\_, Recorded Plat \_\_\_\_\_  
5. Private Claims \_\_\_\_\_

I, John C. Bueche, in a field survey on April 2, 19 98, do hereby certify that under requirements of P.A. 74, Michigan P.A. of 1970, the corner points mentioned in lines 1 and 2 above were in conformance with regulations and rules therefore as required in the current manual of survey instructions of the United States Department of the Interior, Bureau of Land Management or by a decree of a Court of Law and/or that the corner points mentioned in lines 3, 4 and 5 above were in conformance with the rules of the Michigan Board of Land Surveyors or by a Decree of a Court of Law; established, re-established, monumented, re-monumented, recovered, found as expressed below:

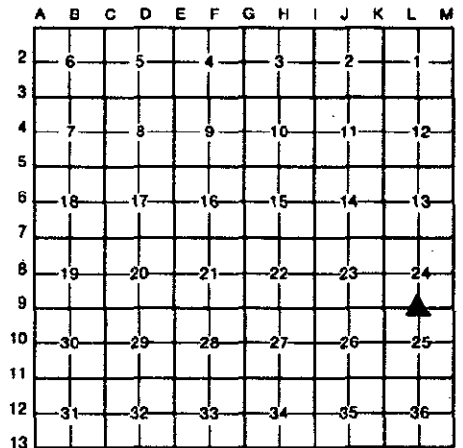

**NOTE: Not more than 4 corners, all in the same town and range, may be recorded on this certificate.**

**A. Description of original monument and accessories and/or subsequent restoration:**

L-9 GLO, 1831 Calvin Britain West corrected line between secs. 24 & 25 40.04' Set qr. Sec. post W. Oak 12 N 2 W 13 Beech 10 S 17 E 29	LCRC 1-320, June, 1972 Fnd. 1" iron, Ratekin 1/2" iron S. 33.00' 9" W. Oak S 30° E 29.66' to nail NE side 14" W. Cherry N 20° W 40.48' to nail SW side 16" Oak N 60° E 81.66' to nail S side	LCRC 3-297, Oct., 1980 Set, Glaza Capped iron on Line between SW & SE @ propated meas. Nail E. side PP S 10° W 19.85' Nail NW side 12" Oak S 20° W 27.45' Nail SW side 10" Oak N 50° W 34.70'
---	--	---

OVER

**B. Description of corner evidence found and/or method applied in restoring or reestablishing corner:**

L-9 Found 1" x 30" solid bar on C/L gravel road E-W; no field division N or S  
As per LCRC 1-320 & survey 1025-469 & survey 1311-35

**APPROVED REMONUMENTATION CORNER**  
P.A. 345 OF 1990  
ALLEGAN COUNTY  
DATE APPROVED APRIL 14, 1998  
COUNTY REP. [Signature]

And is accepted as a careful and faithful perpetuation of the position of the original corner.

Found 1" pipe as per LCRC 3-297 & survey 1099-775  
S 80° E 31.9' from other iron

Was established using improper procedures and is not utilized in this survey.

**C. Description of monument for corner and accessories established to perpetuate locating the position of the corner:**

L-9 Replaced solid bar with 3/4" x 36" pin with Allegan Co. cap in gravel road, 0.5' below grade  
Nail & Allegan Co. Remon. Tag in S side 22" Oak N 65° E 81.65'  
Nail & Allegan Co. Remon. Tag in E side 10" Oak N 0° E 44.72'  
Nail & Allegan Co. Remon. Tag in NE side 14" Oak N 55° W 73.55'  
Nail & Allegan Co. Remon. Tag in W side 14" Oak S 25° W 34.04'  
Nail & Allegan Co. Remon. Tag in E side Twin 14" Maple S 50° W 60.31'  
On C/L gravel road E-W  
Iron S 80° E 31.9'



Signed by John C. Bueche Date 4-13-98  
John C. Bueche, P.S. 13027  
Surveyor's Michigan License No. \_\_\_\_\_

SURVEY  
REMONUMENTATION

APR 29 1988

SECTION

L-9 SALEM TWP.  
PART A - CONTINUED

Survey L1025, P469, Sept., 1982  
Fnd. 1" solid bar, Jonker  
Nail in W side 18" W. Cherry N 15° W 40.48'  
Nail in E side 10" Oak S 20° W 34.03'  
PK NE side PP S 50° E 34.26'  
C/L gravel road South 1'±

Survey 1991 Nederveld  
Same as above  
Iron pipe South 33.00'

Survey 1099-775  
3-85  
Tri-County  
Same as LCRC 3-297

LIBERO 007 PAGE 80