

APR 20 1998

SECTION

Allegan County Remonumentation  
LAND CORNER RECORDATION CERTIFICATE  
Filing Requirement of Act 74, Mich. P.A. 1970

For corners in

Allegan (County)	Located In:	Corner Code #
1. Public Land Survey	T <u>4N</u> R <u>13W</u>	<u>M-9 (NE, 25)</u>
	T _____ R _____	<u>Salem Twp.</u>
	T _____ R _____	_____
	T _____ R _____	_____
2. Property Controlling in Section	S _____ T _____ R _____	_____
	S _____ T _____ R _____	_____
3. Miscellaneous Property in Sec.	S _____ T _____ R _____	_____
	S _____ T _____ R _____	_____

FILED

1/28/1999 2:44:39 PM

JOYCE A. WATTS  
REGISTER OF DEEDS  
ALLEGAN COUNTY, MICH

LIBERO 007 PAGE 81

Register of Deeds Stamp & File Number

- 4. Lot No. \_\_\_\_\_, Recorded Plat \_\_\_\_\_
- 5. Private Claims \_\_\_\_\_

	A	B	C	D	E	F	G	H	I	J	K	L	M
2	6		5		4		3		2		1		
3													
4	7		8		9		10		11		12		
5													
6	18		17		16		15		14		13		
7													
8	19		20		21		22		23		24		
9													
10	30		29		28		27		26		25		
11													
12	31		32		33		34		35		36		
13													

I, John C. Bueche, in a field survey on April 2, 19 98, do hereby certify that under requirements of P.A. 74, Michigan P.A. of 1970, the corner points mentioned in lines 1 and 2 above were in conformance with regulations and rules therefore as required in the current manual of survey instructions of the United States Department of the Interior, Bureau of Land Management or by a decree of a Court of Law and/or that the corner points mentioned in lines 3, 4 and 5 above were in conformance with the rules of the Michigan Board of Land Surveyors or by a Decree of a Court of Law; established, re-established, monumented, re-monumented, recovered, found as expressed below:

**NOTE: Not more than 4 corners, all in the same town and range, may be recorded on this certificate.**

A. Description of original monument and accessories and/or subsequent restoration:

M-9 GLO, 1831	LCRC 1-320, June, 1972	LCRC 3-344, Sept., 1982, Muller
Calvin Britain	Found 1" iron, Ratekin	Found iron & cap
80.00' set post cor.	32" Oak N 25° E 68.4'	Spk. 36" Oak NNE 69.39'
Secs. 24 & 25	St. sign S 75° E 31.2'	BM SW 32.41'
Maple 9 S 24 W 12	Tel. cable post S 40° E 61.2'	Spk. 24" Oak SE 60.20'
Beech 10 N 35 W 18	13" Oak S 38° E 60.8'	Spk. 24" Oak SSW 52.19'
	USGS BM S 30° W 32.3'	NW cor. Sec. 30 S 50.85'
	under bit.	
	26" Oak S 25° W 35.9'	

B. Description of corner evidence found and/or method applied in restoring or reestablishing corner:


M-9 Found 3/4" solid rod in Mon. Box; on C/L bit. road N-S; on C/L gravel road West  
 Tel. cable post S 40° E 61.2'±  
 13" Oak S 38° E 60.8'±      Spk. 24" Oak SE 60.20'±  
 NW cor. Sec. 30 S 50.85'±

And is accepted as a careful and faithful perpetuation of the position of the original corner.

APPROVED REMONUMENTATION CORNER  
 P.A. 345 OF 1990  
 ALLEGAN COUNTY  
 DATE APPROVED APRIL 14, 1998  
 COUNTY REP. [Signature]

C. Description of monument for corner and accessories established to perpetuate locating the position of the corner:

M-9 Replaced 3/4" solid rod with 3/4" x 24" pin with Allegan Co. cap in Mon. Box  
 Nail & Allegan Co. Remon. Tag in N side 22" Pine S 65° W 96.40'  
 Nail & Allegan Co. Remon. Tag in SW side 32" Oak S 35° E 61.31'  
 Nail & Allegan Co. Remon. Tag in E side 6" Catulpa N 60° W 51.91'  
 Nail & Allegan Co. Remon. Tag in NE side 16" Pine N 75° W 76.77'  
 Iron in Mon. Box South 58.87'  
 On C/L bit. road N-S; on C/L gravel road W

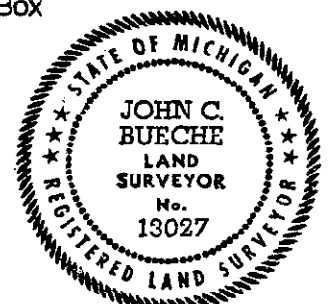

Signed by John C. Bueche Date 4-13-98  
 John C. Bueche, P.S. 13027  
 Surveyor's Michigan License No. \_\_\_\_\_