

MAR 07 2000

FILED

SECTION

ALLEGAN COUNTY REMONUMENTATION

LAND CORNER RECORDATION CERTIFICATE
Filing Requirement of Act 74, Mich. P.A. 1970

00 FEB -1 AM 8:38

RECORDED / FILED

For corners in

<u>Allegan</u> (County)	Located in:	Corner Code #
1. Public Land Survey	T4N R12W	A-11
	T R	Dorr Twp.
	T4N R13W	M-11 ✓
	T R	Salem Twp.
2. Property Controlling in Section	S T R	
	S T R	
3. Miscellaneous Property in Sec.	S T R	
	S T R	

Joyce A. State
REGISTER OF DEEDS
ALLEGAN COUNTY, MICH.

Register of Deeds Stamp & File Number

4. Lot No. _____, Recorded Plat _____
 5. Private Claims _____

I, Kirk L Van Order, in a field survey on July 13, 1999 do hereby state that under requirements of P.A. 74, Michigan P.A. of 1970, the corner points mentioned in lines 1 and 2 above were in conformance with regulations and rules therefore as required in the current manual of survey instructions of the United States Department of the Interior, Bureau of Land Management or by a decree of a Court of Law and/or that the corner points mentioned in lines 3, 4 and 5 above were in conformance with the rules of the Michigan Board of Land Surveyors or by a Decree of a Court of Law; established, re-established, monumented, recovered, found as expressed below:

NOTE: Not more than 2 corners, all in the same town and range, may be recorded on this certificate.

APPROVED REMONUMENTATION CORNER
 P.A. 345 OF 1990
 ALLEGAN COUNTY
 DATE APPROVED July 13, 1999
 COUNTY REP. [Signature]

A	B	C	D	E	F	G	H	I	J	K	L	M
1												
2	6		5		4		3		2		1	
3												
4	7		8		9		10		11		12	
5												
6	18		17		16		15		14		13	
7												
8	19		20		21		22		23		24	
9												
10	30		29		28		27		26		25	
11												
12	31		32		33		34		35		36	
13												

A. Description of original monument and accessories and/or subsequent restoration:

- (1) GLO North 80.00 Set post corner Sec. 25 & 36
Pine 7" dia. bears N.21W. 7 lks
Pine 17" dia. bears S.58W. 20 lks
- (2) H. MacDougall notes show a stone at corner, dated March 1911.
- (3) D.A. Ratekin survey dated 5-18-1978 shows 1" iron, C/L rd. to North is West 12' +/- . No other ties given.
- (4) Wightman-Moored, Inc. survey dated 7-05-1995, by Donald R. Pitts, Jr., shows no ties for corner.


B. Description of corner evidence found and/or method applied in restoring or reestablishing corner. (continued on back of sheet)

Fd. 1/2" steel re-rod in top of 1" dia. steel pipe 2' long with glass, brick and broken crockery around corner. Used tie info. as stated in No. 6 of Part A and is accepted as a careful and faithful perpetuation of the position of the original corner. Note: Did not find stone as stated in No. 2 of Part A. Replaced fd. re-rod and pipe with standard Allegan Co. monument. This corner is common to A-11, T.4N., R.12W., Dorr Twp. Peer group approved July 13, 1999.

C. Description of monument for corner and accessories established to perpetuate locating the position of the corner:

Set standard Allegan Co. Remon. monument (3/4" x 24" steel rod w/red cap #23520)
 Set nail & Remon. tag in NW side b. oak N35°E 89.08'
 Set nail & Remon. tag in W side 34" w. oak South 53.96'
 Set nail & Remon. tag in E side 22" w. oak S15°W 76.57'
 Set nail & Remon. tag in SW side power pole N25°W 59.89'
 Fd. "T" iron South 3.82'

Signed by [Signature]
 Surveyor's Michigan License No. 3520

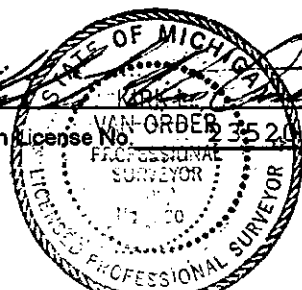

Date 12-30-1999

RE

MAR 07 2000

SECTION

LIBRARY / MAR 22 1

Section A (continued from Page 1)

M-11

Salem Twp., T.4N., R.13W.

- (5) Jonker survey notes dated 4-22-1988. Fd. capped re-rod, Ray Moored okay per wit. of #83758.
- (6) Kirk Van Order survey notes dated 6-23-1998.
 - Fd. capped iron
 - Fd. PK in NE side power pole NW 57.89'
 - Fd. PK in NW side 18" b. oak NE 87.00'
 - Fd. PK in W side 34" w. oak S 51.95'
 - Set nail in SE side 30" w. oak E,NE 93.39'