

Allegan County Remonumentation  
**LAND CORNER RECORDATION CERTIFICATE**  
 Filing Requirement of Act 74, Mich. P.A. 1970

For corners in

Allegan Co.  
(County)

Located in: 4 twps.

Corner Code #

1. Public Land Survey

T 4N R 12W A-13 DARR  
 T 3N R 12W A-1 HOPKINS  
 T 3N R 13W M-1 MONTREY  
 T 4N R 13W M-13 SALETT

2. Property Controlling in Section

S \_\_\_ T \_\_\_ R \_\_\_  
 S \_\_\_ T \_\_\_ R \_\_\_

3. Miscellaneous Property in Sec.

S \_\_\_ T \_\_\_ R \_\_\_  
 S \_\_\_ T \_\_\_ R \_\_\_

**SURVEY &  
 REMONUMENTATION**

APR 29 1996

1995 DEC 14 PM 2:33  
 REGISTER OF DEEDS  
 ALLEGAN COUNTY, MICHIGAN  
 FILED


Register of Deeds Stamp & File Number

**COMMISSION**

Lot No. \_\_\_\_\_ Recorded Plat \_\_\_\_\_  
 Private Claims \_\_\_\_\_

T3N, R12W T3N, R13

I, Robert J. Jonker in a field survey on December 13 19 94 do hereby certify that under requirements of P.A. 74, Michigan P.A. of 1970, the corner points mentioned in lines 1 and 2 above were in conformance with regulations and rules therofore as required in the current manual of survey instructions of the United States Department of the Interior, Bureau of Land Management or by a decree of a Court of Law and/or that the corner points mentioned in lines 3, 4 and 5 above were in conformance with the rules of the Michigan Board of Land Surveyors or by a Decree of a Court of Law; established, re-established, monumented, re-monumented, recovered, found as expressed below:

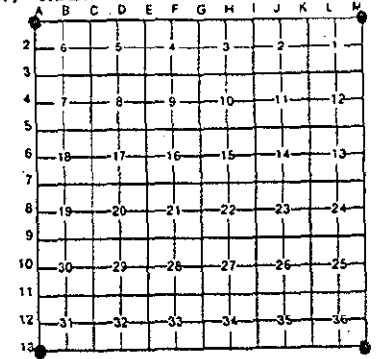

NOTE: Not more than 4 corners, all in the same town and range, may be recorded on this certificate.

A. Description of original monument and accessories and/or subsequent restoration:

G.L.O. survey, May 3, 1831, P.231, & P.259	LCRC, L.3, P.211, Ratekin	T4N, R12W	T4N, R13
Lucius Lyon, D.S.	Fd. 1" Pipe, 1978, In C/L road		
Beech 17 S 50° E 12	PK NW side 24" Oak	S34°W	35.70'
Beech 7 N 25° W 36	PK SW side 30" Oak	S55°E	56.06'
	PK SE side 12" Hickory	N30°E	27.57'
	PK E. side P. pole	N10°E	55.71'
1972, Russ Donker, Iron			
14" Maple NNE	27.0'		
24" Oak SW	34.7'		
28" Oak SE	55.0'		

B. Description of corner evidence found and/or method applied in restoring or reestablishing corner:

Found 1" Iron pipe by all the witnesses located in "A" above for the recorded L.C.R.C.


APPROVED REMONUMENTATION CORNER  
 P.A. 345 OF 1990  
 ALLEGAN COUNTY  
 DATE APPROVED 12-14-95  
 COUNTY REP. Robert J. Jonker

This monument is accepted by me as a careful and faithful perpetuation of the position of the corner.

Peer group approved on 12-14-95.

C. Description of monument for corner and accessories established to perpetuate locating the position of the corner:

Replaced and set 3' std. Allegan County monument, capped with remon. cap.  
 A/C Nail & tag, W. side P. pole N 00° E 56.32'  
 A/C Nail & tag, N. side 24" Oak S 80° W 124.0'  
 A/C Nail & tag, E. side 30" Oak S 35° W 34.98'  
 A/C Nail & tag, W. side 10" Sas. S 10° E 53.68'  
 on C/L E-W road  
 Capped Iron S. 32.94'

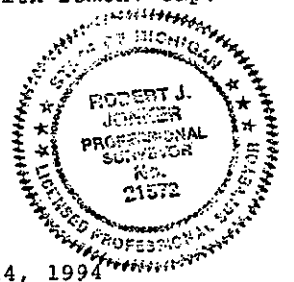

Signed by Robert J. Jonker  
 Surveyor's Michigan License No. JONKER LAND SURVEYS 21572

Date December 14, 1994