

MAR 07 2000

ALLEGAN COUNTY REMONUMENTATION PROGRAM
LAND CORNER RECORDATION CERTIFICATE
Filing Requirement of Act 74, Mich. P.A. 1970

SECTION

For corners in

ALLEGAN Located In: OVERISEL Corner Code #
(County) (Township)

1. Public Land Survey T 4N R 14W A-4
T ___ R ___
T ___ R ___ WEST 1/4 CORNER
T ___ R ___ SECTION 7

2. Property Controlling S ___ T ___ R ___
in Section S ___ T ___ R ___

3. Miscellaneous S ___ T ___ R ___
Property in Sec. S ___ T ___ R ___

REGISTER OF DEEDS
ALLEGAN COUNTY MI

00 FEB - 1 AM 8:43

FILED

REGISTER OF DEEDS Stamp & Number

4. Lot No. _____, Recorded Plat _____
5. Private Claims _____

I, Robert E. Lemke, surveyor, in a field survey on March 13, 1999 do hereby state that under requirements of P.A. 74, Michigan P.A. of 1970, the corner points mentioned in lines 1 and 2 above were in conformance with regulations and rules therefore as required in the current manual of survey instructions of the United States Department of the Interior, Bureau of Land Management or by a decree of a Court of Law and /or that the corner points mentioned in lines 3, 4 and 5 above were in conformance with the rules of the Michigan Board of Land Surveyors or by a Decree of a Court of Law; established, re-established, monumented, recovered, found as expressed below:

A	B	C	D	E	F	G	H	I	J	K	L
1											
2	6		5		4		3		2		1
3											
4	7		8		9		10		11		12
5											
6	18		17		16		15		14		13
7											
8	19		20		21		22		23		24
9											
10	30		29		28		27		26		25
11											
12	31		32		33		34		35		36
13											

NOTE: Not more than 2 corners, all in the same town and range, may be recorded on this certificate.

A. Description of original monument and accessories and/or subsequent restoration:

SEE BACK OF SHEET FOR CORNER HISTORY

B. Description of corner evidence found and/or method applied in restoring or reestablishing corner:

A-4
FOUND 1/2" IRON BAR IN MONUMENT BOX

FOUND 5/8" IRON BAR IN MONUMENT BOX AT FILLMORE TOWNSHIP CORNER N 72.67'
FOUND NAIL ON SOUTH SIDE OF 18" DIAMETER MAPLE NW 77.33'
MEASURED TO CENTER OF 36" DIAMETER MULTI-TRUNKED MAPLE (NO NAIL) NE 67.9'
FOUND IRON IS ON THE RANGE LINE BETWEEN M-4 AND M-5.

MEASUREMENTS

A-4 TO B-4	A-4 TO A-5	A-4 TO A-3
2140.86'(SDI)	2642.82'(SDI)	2636.37'(SDI)
2140.75'(WIGHTMAN)	2642.86'(WIGHTMAN)	2636.35'(WIGHTMAN)
2142.69'(COUNTY NOTES)		2636.04'(HEI)
		2636.04'(KISTLER)

(DISTANCE TRAVERSED=5279')

This position not established by original government surveyors. This monument is accepted as the best available evidence of the position of the corner. Replaced found 1/2" iron bar with a 3/4" x 24" Allegan County remonumentation iron and cap #23520 in monument box.

PEER GROUP APPROVED DECEMBER 14, 1999

C. Description of monument for corner and accessories established to perpetuate locating the position of the corner:

A-4
SET 3/4" x 24" ALLEGAN COUNTY REMONUMENTATION IRON AND CAP #23520 IN MONUMENT BOX.


SET NAIL WITH ALLEGAN CO. REMON. TAG ON SOUTH SIDE OF 18" MAPLE 24" ABOVE GROUND	N30°W	77.30'
SET NAIL WITH ALLEGAN CO. REMON. TAG ON N.W. SIDE OF 36" MAPLE 24" ABOVE GROUND	N48°E	68.08'
SET NAIL WITH ALLEGAN CO. REMON. TAG ON S.W. SIDE OF (2) 8" TREES 24" ABOVE GROUND	S32°E	60.87'
SET P.K. NAIL WITH ALLEGAN CO. REMON TAG 4' EAST OF WEST EDGE OF ASPHALT 48 TH St.	S14°W	49.46'
FOUND 5/8" IRON BAR IN MONUMENT BOX AT FILLMORE TOWNSHIP CORNER	N	72.67'

WEST 1/4 CORNER SECTION 7 IS 0.5' WEST OF CENTERLINE 48TH ST.

Signed by Robert E. Lemke Date 12-30-1999

For SDI CONSULTANTS, LTD

Surveyor's Michigan License No. 40160

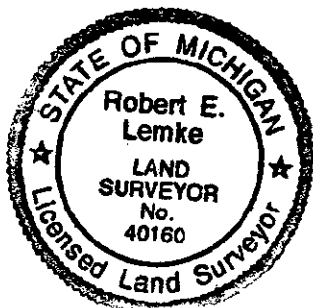

SHEET 1 OF 2

FORM APPROVED BY MICHIGAN STATE BOARD OF PROFESSIONAL SURVEYORS
JAN. 28, 1971 REVISED MAY 14, 1975
REVISED JAN., 1983
REVISED OCT., 1995

APPROVED REMONUMENTATION CORNER
P.A. 345 OF 1990
ALLEGAN COUNTY

DATE APPROVED DEC 14, 1999
COUNTY REP. [Signature]

MAR 07 2000

**T.4N., R.14W. A-4 CONTINUED
OVERISEL TWP.**

SECTION

NOT SET BY GLO

E.P. WATERMAN, COUNTY SURVEYOR FIELD NOTES, 1891
STONE

116 LKS JOG (76.56')
A-4 TO B-4 = 32.42 CHAINS
A-4 TO A-5 = 39.98 1/4 CHAINS

RUSSELL L. ROON, L.C.R.C. LIBER 2 PAGE 94, MAY 4, 1973
FND IRON IN MON BOX

FILLMORE TWP. COR. N 72.65'
14" MAPLE NW 77.50'
TEL. POLE NE 53.38'
20" MAPLE NE 67.85'

JOHN KISTLER & ASSOCIATES, INC., RUSSELL ROON, RECORDED SURVEY, L. 830 P. 223, 5-4-73
FOUND IRON IN MONUMENT BOX

FILLMORE TWP. COR. N. 72.65'
14" MAPLE NW 77.50'
TELEPHONE POLE NE 53.38'
20" MAPLE NE 67.85'
A-4 TO A-3 = N00°00'00"W 2636.04'

HOLLAND ENGINEERING INC., JOHN P. CLAPP, RECORDED SURVEY, LIBER 919 PAGE 727, 5-26-77
FD. STEEL BAR IN MON BOX

14" MAPLE NW 77.50'
TEL. POLE NE 53.38'
20" MAPLE NE 67.85'
FILLMORE TWP, COR. N. 72.65'
A-4 TO A-3 = NORTH 2636.04'
(HOLLAND ENG ALSO SHOWS SAME WITNESSES ON
RECORDED SURVEY, LIBER 919 PAGE 744, 5-26-77)

WIGHTMAN MOORED, INC., FIELD NOTES FOR BOUNDARY SURVEY, 12-09-92
MON BOX

A-4 TO A-5 = S00°00'10"W 2642.86'
A-4 TO B-4 = S86°45'00"E 2140.75'
A-4 TO A-3 = NORTH 2636.38'

HOLLAND ENGINEERING SECTION CARD
REPEAT OF JK & A WITNESSES

WIGHTMAN MOORED SECTION CARD

IRON
TEL POLE NNE 73.9'
10" MAPLE NW 77.65'

LIBER 007 PAGE 01