

**SURVEY  
REMONUMENTATION**

APR 29 1999

**SECTION**

**ALLEGAN COUNTY REMONUMENTATION  
LAND CORNER RECORDATION CERTIFICATE  
Filing Requirement of Act 74, Mich. P.A. 1970**

LIBERO 007 PAGED 26

For corners in <u>Allegan</u> (County)	Located In:	Corner Code #
1. Public Land Survey	T4N R14W	A-6
	T R	West 1/4 corner
	T R	Section 18
	T R	Overisel Twp.
2. Property Controlling in Section	S T R	
	S T R	
3. Miscellaneous Property in Sec.	S T R	
	S T R	
4. Lot No. _____, Recorded Plat _____		
5. Private Claims _____		

FILED

1/28/1999 2:44:39 PM

JOYCE A. WATTS  
REGISTER OF DEEDS  
ALLEGAN COUNTY, MICH

Register of Deeds Stamp & File Number

I, Steve Lampen, in a field survey on December 19, 1998, do hereby certify that under requirements of P.A. 74, Michigan P.A. of 1970, the corner points mentioned in lines 1 and 2 above were in conformance with regulations and rules therefore as required in the current manual of survey instructions of the United States Department of the Interior, Bureau of Land Management or by a decree of a Court of Law and/or that the corner points mentioned in lines 3, 4 and 5 above were in conformance with the rules of the Michigan Board of Land Surveyors or by a Decree of a Court of Law; established, re-established, monumented, re-monumented, recovered, found as expressed below:

**NOTE: Not more than 4 corners, all in the same town and range, may be recorded on this certificate.**

**A. Description of original monument and accessories and/or subsequent restoration:**  
A-6 Survey - L 1191, P537 - 1986 - Kirk Van Order  
GLO - corner Found iron in monument box  
Not set by GLO Capped iron E 33.05  
PK nail S 198.0  
County Records Capped S, SE 202.46  
Iron Located on centerline 48th Street pavement  
Iron East 50.0  
Iron West 50.0  
A-6 to A-5 = 2635.49

**B. Description of corner evidence found and/or method applied in restoring or reestablishing corner:**  
A-6 Found 3/4" iron in monument box in centerline 48th Street pavement on East line of Section 13, Town 4 North, Range 15 West  
A-6 to a-5 rec. = 2635.49 meas. = 2635.69

Replaced 3/4" iron with 3/4"x24" Allegan County Remonumentation iron and cap. This corner was not monumented by the original GLO Survey. This position is accepted as the best evidence of the position of the corner.


Traversed 2647 ft. on road.

A-6 was approved by the Allegan County Remonumentation Peer Group on December 22, 1998.

APPROVED REMONUMENTATION CORNER  
P.A. 345 OF 1990  
ALLEGAN COUNTY  
DATE APPROVED DEC. 22, 1998  
COUNTY REP. *[Signature]*

**C. Description of monument for corner and accessories established to perpetuate locating the position of the corner:**  
A-6 3/4"x24" Allegan County Remonumentation iron and cap in monument box on the East line of Section 13, Town 4 North, Range 15 West  
Azimuth = Michigan State Plane grid direction  
Power pole, remonumentation tag in W side 8° 11' 197.15  
Power pole, remonumentation tag in W side 2° 03' 590.62  
Power pole, remonumentation tag in W side 169° 51' 205.65  
Centerline N and S asphalt road pavement 270° 0.1  
M-6, Town 4 North, Range 15 West 359° 07' 54.08

	A	B	C	D	E	F	G	H	I	J	K	L	M
1													
2	6	5	4	3	2	1							
3													
4	7	8	9	10	11	12							
5													
6	18	17	16	15	14	13							
7													
8	19	20	21	22	23	24							
9													
10	30	29	28	27	26	25							
11													
12	31	32	33	34	35	36							
13													

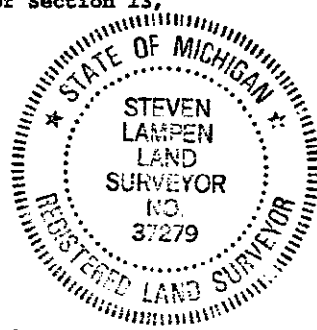

Signed by Steven Lampen Date JANUARY 11, 1999

Surveyor's Michigan License No. 37279