

**SURVEY
REMONUMENTATION**

APR 29 1999

**ALLEGAN COUNTY REMONUMENTATION
SECTION LAND CORNER RECORDATION CERTIFICATE**

Filing Requirement of Act 74, Mich. P.A. 1970

FILED

For corners in <u>Allegan</u> <small>(County)</small>	Located In:	Corner Code #
1. Public Land Survey	T4N R14W	A-9
	T R	NW corner
	T R	Section 30
	T R	Oversiel Twp.
2. Property Controlling in Section	S T R	
	S T R	
3. Miscellaneous Property in Sec.	S T R	
	S T R	

1/28/1999 2:44:39 PM

JOYCE A. WATTS
REGISTER OF DEEDS
ALLEGAN COUNTY, MICH

Register of Deeds Stamp & File Number

LHRO007 PAGE 29

4. Lot No. _____, Recorded Plat _____
5. Private Claims _____

I, Steve Lampen, in a field survey on December 19, 1998, do hereby certify that under requirements of P.A. 74, Michigan P.A. of 1970, the corner points mentioned in lines 1 and 2 above were in conformance with regulations and rules therefore as required in the current manual of survey instructions of the United States Department of the Interior, Bureau of Land Management or by a decree of a Court of Law and/or that the corner points mentioned in lines 3, 4 and 5 above were in conformance with the rules of the Michigan Board of Land Surveyors or by a Decree of a Court of Law; established, re-established, monumented, re-monumented, recovered, found as expressed below:

NOTE: Not more than 4 corners, all in the same town and range, may be recorded on this certificate.

A. Description of original monument and accessories and/or subsequent restoration:
A-9 Consumers Power Co. - 1968
GLO - Britain - Brookfield - 1831, 1832 1" iron set
West between Sec. 19 and 30 75.15 West 18" Box Elder ESE 69.39
Boundary 42 S of post and set corner Street sign NE 33.26
To Sections 19 and 30 Fence corner NW 64.35
Sugar 18 N 79 E 7 Stop sign WNW 47.6
Lynn 30 S 50 E 18 M-9, Town 4 North, Range 15 W N 27.72
B-9 E 2322.33

B. Description of corner evidence found and/or method applied in restoring or reestablishing corner:
A-9 Found 3/4" iron in monument box 0.36' West of East line of Section 25, Town 4 North, Range 15 West
M-9, Town 4 North, Range 15 West N rec. = 27.72 meas. = 27.85 A-9 to B-9 rec. = 2322.33 meas. = 2322.58
Replaced iron with 3/4"x24" Allegan County Remonumentation iron and cap on East line of Section 25, Town 4 North, Range 15 West and accepted it as a careful and faithful perpetuation of the position of the original Corner.


Traversed 2636 ft. on road

A-9 was approved by the Allegan County Remonumentation Peer Group on December 22, 1998.

APPROVED REMONUMENTATION CORNER
P.A. 345 OF 1990
ALLEGAN COUNTY
DATE APPROVED DEC. 22, 1998
COUNTY REP. John L. Allen

C. Description of monument for corner and accessories established to perpetuate locating the position of the corner:
A-9 3/4"x24" Allegan County Remonumentation iron and cap in monument box on the East line of Section 25, Town 4 North, Range 15 West
Azimuth = Michigan State Plane grid direction

12" Oak, remonumentation tag in NW side	41° 22'	89.76
8" Maple, remonumentation tag in NW side	27° 51'	104.48
8" Ash, remonumentation tag in NE side	134° 34'	79.68
10" Oak, remonumentation tag in W side	153° 17'	95.48
M-9, town 4 North, Range 15 West	359° 56'	27.86

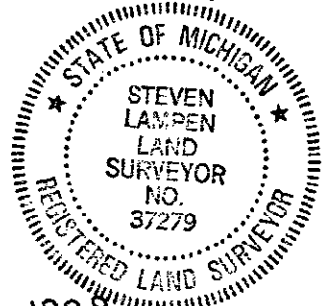

Signed by Steven Lampen Date JANUARY 11, 1999

Surveyor's Michigan License No. 37279