

**SURVEY
REMONUMENTATION**

APR 29 1999

SECTION

**ALLEGAN COUNTY REMONUMENTATION
LAND CORNER RECORDATION CERTIFICATE
Filing Requirement of Act 74, Mich. P.A. 1970**

FILED

For corners in
Allegan
(County)

Located In: Corner Code #

1. Public Land Survey T4N R14W A-10
T R
T R West 1/4 corner,
T R Section 30, Overisel
Twp.

2. Property Controlling S T R
in Section S T R
3. Miscellaneous S T R
Property in Sec. S T R

4. Lot No. _____, Recorded Plat _____

5. Private Claims _____

1/28/1999 2:44:39 PM

JOYCE A. WATTS
REGISTER OF DEEDS
ALLEGAN COUNTY, MICH

Register of Deeds Stamp & File Number

LIBERO 007 PAGE 30

I, Steve Lampen, in a field survey on December 19, 1998, do hereby certify that under requirements of P.A. 74, Michigan P.A. of 1970, the corner points mentioned in lines 1 and 2 above were in conformance with regulations and rules therefore as required in the current manual of survey instructions of the United States Department of the Interior, Bureau of Land Management or by a decree of a Court of Law and/or that the corner points mentioned in lines 3, 4 and 5 above were in conformance with the rules of the Michigan Board of Land Surveyors or by a Decree of a Court of Law; established, re-established, monumented, re-monumented, recovered, found as expressed below:

NOTE: Not more than 4 corners, all in the same town and range, may be recorded on this certificate.

A. Description of original monument and accessories and/or subsequent restoration:
A-10 Consumers Power Co. 1968
GLO - corner West 1/4 post Section 30
Not set by GLO Set 3/4" iron
3/4" iron (M-10, T4N, R15W) North 30.6
Holland Engineering, Inc. A-10 to M-10, T4N, R15W N 01° 01' 05" E 30.16
Section sheet A-10 to A-9 N 01° 01' 05" E 2638.17
A-10 to A-9 North 2637.89 A-10 to A-11 S 01° 01' 05" W 2638.16

B. Description of corner evidence found and/or method applied in restoring or reestablishing corner:
A-10 Found 3/4"x24" iron in monument box 0.08' West of the East line of Section 25, Town 4 North, Range 15 West
Iron in monument box North rec. = 30.16 meas. = 30.33
A-10 to A-9 rec. = 2638.17 meas. = 2637.73 A-10 to A-11 rec. = 2638.17 meas. = 2638.16
A-10 rec. is on line M-9, town 4 North, Range 15 West, to M-11 meas. = 8.33' East


Replaced iron with 3/4"x24" Allegan County Remonumentation iron and cap on line M-10 to M-11. A-10 was not Monumented by the original GLO Survey. Set iron is accepted as the best available evidence of the position Of the original corner.

Traversed 2636 ft. on road

A-10 was approved by the Allegan County Remonumentation Peer Group on December 22, 1998.

APPROVED REMONUMENTATION CORNER
P.A. 345 OF 1990
ALLEGAN COUNTY
DATE APPROVED DEC. 22, 1998
COUNTY REP. [Signature]

C. Description of monument for corner and accessories established to perpetuate locating the position of the corner:
A-10 3/4"x24" Allegan County Remonumentation iron and cap in monument box on the East line of Section 25, Town 4 North, Range 15 West
Azimuth = Michigan State Plane grid direction
Power pole, remonumentation tag in SE side 338° 52' 252.04
SE corner house, foundation 290° 40' 398.97
Power pole, remonumentation tag in N side 279° 43' 220.58
Power pole, remonumentation tag in E side 183° 38' 441.74
Centerline N and S asphalt road pavement 270° 0'
M-10, Town 4 North, Range 15 West 0° 18' 30.33

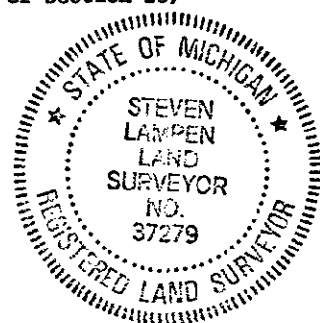

Signed by Steven Lampen

Date JANUARY 11, 1999

Surveyor's Michigan License No. 37279