

APR 07 1998

92

SECTION

Allegan County Remonumentation
LAND CORNER RECORDATION CERTIFICATE
Filing Requirement of Act 74, Mich. P.A. 1970

For corners in

Allegan (County)	Located In:	Corner Code #
1. Public Land Survey	T 4N R 14W	✓ B-1 (N $\frac{1}{2}$, 6) Overisel Twp.
	T _____ R _____	_____
	T _____ R _____	_____
	T _____ R _____	_____
2. Property Controlling in Section	S _____ T _____ R _____	_____
	S _____ T _____ R _____	_____
3. Miscellaneous Property in Sec.	S _____ T _____ R _____	_____
	S _____ T _____ R _____	_____

REGISTER OF DEEDS
ALLEGAN COUNTY, MICH.


98 JAN 21 PM 1:27

FILED

Register of Deeds Stamp & File Number

- 4. Lot No. _____, Recorded Plat _____
- 5. Private Claims _____

I, John C. Bueche, in a field survey on May 9, 19 97, do hereby certify that under requirements of P.A. 74, Michigan P.A. of 1970, the corner points mentioned in lines 1 and 2 above were in conformance with regulations and rules therofore as required in the current manual of survey instructions of the United States Department of the Interior, Bureau of Land Management or by a decree of a Court of Law and/or that the corner points mentioned in lines 3, 4 and 5 above were in conformance with the rules of the Michigan Board of Land Surveyors or by a Decree of a Court of Law; established, re-established, monumented, re-monumented, recovered, found as expressed below:

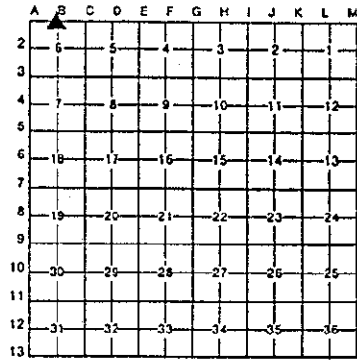

NOTE: Not more than 4 corners, all in the same town and range, may be recorded on this certificate.

A. Description of original monument and accessories and/or subsequent restoration:

B-1 GLO LCRC L2, P379	Survey recorded	Cards
Not set April, 1975	Cannot read L&P	Same wit
Fnd. 1/2" solid iron in Mon. Box	June, 1987	as LCRC
PK nail in 5" tree S 32.50'	Fnd. 3/4" rod in Mon. Box	L2, P379
PK nail in PP N 5° E 116.73'	C/L bit. N 1.6'±	
PK nail in 6" Pine N 75° E 113.36'	1" Pine S 32.83'	
	Top steel fence NW 73.75'	
	PP NE 116.65'	

B. Description of corner evidence found and/or method applied in restoring or reestablishing corner:

B-1 Found 3/4" rerod in Mon. Box on South line Twp. to the North
C/L bit. E-W N 1'±, on old fence line South
As per above wit.
Meas. West 2140.20' NW 6 (LCRC L3, P393 2140.19' to NW 6)
Meas. East 2632.70' NE 6
Traverse A-13 to B-13 2240.50'


This position not established by original government surveyors.
This monument is accepted as the best available evidence of the position of the corner.

Peer group approved May 13, 1997.

APPROVED REMONUMENTATION CORNER
P.A. 245 OF 1990
ALLEGAN COUNTY
DATE APPROVED 5-13-97
COUNTY REP. K.V.O.

C. Description of monument for corner and accessories established to perpetuate locating the position of the corner:

B-1 Replaced 3/4" rerod with Allegan Co. Mon. (3/4" x 24" pin with cap) in Mon. Box
Nail & Ottawa Co. Remon. Tag in N side 10" Maple S 2° W 31.77'
Nail & Allegan Co. Remon. Tag in N side 10" Elm N 50° W 82.06' (6' high)
Nail & 14091 Tag in E side PP N 19° E 117.01'
Nail & Ottawa Co. Remon. Tag in N side 12" Elm N 50° E 122.13'
Ottawa Co. Mon. S $\frac{1}{4}$ 31, 5-14 East 100.30'
C/L bit. E-W North 1'±
On tree line & fence line South

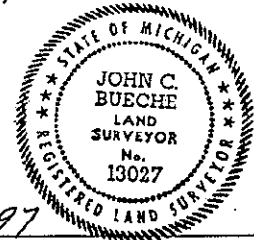

Signed by John C. Bueche Date 10-22-97
Surveyor's Michigan License No. 13027

FORM APPROVED BY MICHIGAN STATE BOARD OF LAND SURVEYORS, JAN. 28, 1971
REVISED MAY 14, 1975
REVISED JAN., 1982

