

MAR 07 2000

ALLEGAN COUNTY REMONUMENTATION PROGRAM  
LAND CORNER RECORDATION CERTIFICATE  
Filing Requirement of Act 74, Mich. P.A. 1970

SECTION

For corners in

ALLEGAN Located In: OVERISEL Corner Code #  
(County) (Township)

1. Public Land Survey T 4N R 14W B-3  
T \_\_\_\_\_ R \_\_\_\_\_  
T \_\_\_\_\_ R \_\_\_\_\_ North 1/4 Corner  
T \_\_\_\_\_ R \_\_\_\_\_ Section 7

2. Property Controlling S \_\_\_\_\_ T \_\_\_\_\_ R \_\_\_\_\_  
in Section S \_\_\_\_\_ T \_\_\_\_\_ R \_\_\_\_\_


3. Miscellaneous S \_\_\_\_\_ T \_\_\_\_\_ R \_\_\_\_\_  
Property in Sec. S \_\_\_\_\_ T \_\_\_\_\_ R \_\_\_\_\_

REGISTER OF DEEDS  
ALLEGAN COUNTY, MICH.  
00 FEB - 1 AM 8:49  
FILED

Register of Deeds Stamp & File Number

4. Lot No. \_\_\_\_\_, Recorded Plat \_\_\_\_\_  
5. Private Claims \_\_\_\_\_

I, Robert E. Lemke, surveyor, in a field survey on March 13, 1999 do hereby state that under requirements of P.A. 74, Michigan P.A. of 1970, the corner points mentioned in lines 1 and 2 above were in conformance with regulations and rules therefore as required in the current manual of survey instructions of the United States Department of the Interior, Bureau of Land Management or by a decree of a Court of Law and /or that the corner points mentioned in lines 3, 4 and 5 above were in conformance with the rules of the Michigan Board of Land Surveyors or by a Decree of a Court of Law; established, re-established, monumented, recovered, found as expressed below:

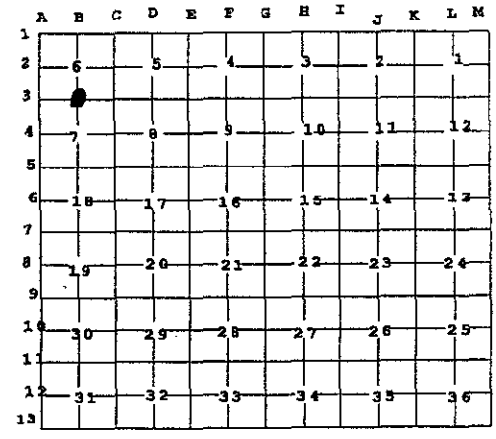

NOTE: Not more than 2 corners, all in the same town and range, may be recorded on this certificate.

A. Description of original monument and accessories and/or subsequent restoration:  
SEE BACK OF SHEET FOR CORNER HISTORY

APPROVED REMONUMENTATION CORNER  
P.A. 345 OF 1990  
ALLEGAN COUNTY  
DATE APPROVED MAY 11, 1999  
COUNTY REP. [Signature]

B. Description of corner evidence found and/or method applied in restoring or reestablishing corner:  
B-3  
FOUND 1/2" RE-ROD (NOT IN MONUMENT BOX)

FOUND NAIL WITH TAG ON N.W.'LY SIDE OF WOOD POWER POLE S. 43° W. 60.50'  
FOUND 1/2" IRON BAR WITH CAP "HEI #14091" N. 40° W. 48.03.

MEASURED A-3 TO B-3 MEASURED B-3 TO B-4  
G.L.O. 2131.14' SDI 2638.61'  
WATERMAN 2134.44' WIGHTMAN 2638.64'  
WIGHTMAN 2131.13'  
SDI 2131.11'  
(DISTANCE TRAVERSED=2131')

ACCEPTED AS A CAREFUL AND FAITHFUL PERPETUATION OF THE POSITION OF THE ORIGINAL CORNER AND SET 3/4" X 24" ALLEGAN COUNTY REMONUMENTATION IRON AND CAP #23520 IN MONUMENT BOX.

PEER GROUP APPROVED MAY 11, 1999  
C. Description of monument for corner and accessories established to perpetuate locating the position of the corner:  
B-3  
SET 3/4" X 24" ALLEGAN COUNTY REMONUMENTATION IRON AND CAP #23520 IN MONUMENT BOX.

FOUND 1/2" IRON BAR WITH CAP "HEI #14091" N 40° W 48.03'  
"STOP" SIGN AT THE CENTER OF THE POST AT GRADE N 20° W 33.83'  
"ROAD ENDS" SIGN AT THE CENTER OF THE POST AT GRADE N 18° E 65.16'  
"STOP" SIGN AT THE CENTER OF THE POST AT GRADE S 20° E 68.53'  
SET NAIL WITH ALLEGAN CO. REMON. TAG ON N.W.'LY SIDE OF WOOD POWER POLE S 43° W 60.52'  
FOUND 1/2" IRON BAR WITH CAP "KVO #23520" S 46° W 45.35'

MONUMENT IS 1'+/- NORTH OF THE CENTERLINE OF 146TH AVENUE EXTENDED FROM WEST TO EAST AND IS 4'+/- WEST OF THE CENTERLINE OF 47TH STREET.

Signed by Robert E. Lemke Date 12-30-1999  
For SDI CONSULTANTS, LTD

Surveyor's Michigan License No. 40160



SHEET 1 OF 2

FORM APPROVED BY MICHIGAN STATE BOARD OF PROFESSIONAL SURVEYORS  
JAN. 28, 1971 REVISED MAY 14, 1975  
REVISED JAN., 1983  
REVISED OCT., 1995

MAR 07 2000

## SECTION

T.4N., R.14W. B-3 CONTINUED  
OVERISEL TWP.

- 1) G.L.O.  
WEST BETWEEN SECTIONS 6 & 7  
40.00 CHAINS SET QR SEC.POST  
18" LYNN S63W 6 LINKS  
10" SUGAR N6W 25 LINKS
- 2) E.P. WATERMAN, COUNTY SURVEYOR NOTES, JUNE 1891  
LARGE STONE  
LOCATED ¼ POST IN S. LINE OF SEC. STRAIGHT LINE BETWEEN  
SEC COR'S AT 40.00 CHS W. OF S.E. COR. OF SEC.  
B-3 TO C-3 = 40.00 CHAINS
- 3) E.P. WATERMAN, COUNTY SURVEYOR NOTES, 1891  
A-3 TO B-3 = 32.34 CHAINS  
B-3 TO C-3 = 40.00 CHAINS
- 4) DONALD A. RATEKIN, BOUNDARY SURVEY, 4-27-68  
B-3 TO B-4 = 2638.70'
- 5) RUSSELL L. ROON, L.C.R.C. LIBER 2 PAGE 94, MAY 4, 1973  
FND. IRON  
GAS LINE MARKER NNW 31.35'  
POWER POLE SW 60.45'
- 6) EXXEL ENGINEERING INC., DOUGLAS W. BONNEMA, BOUNDARY SURVEY, JULY 30, 1982  
RE-ROD  
NAIL & TAG IN NW SIDE P.POLE S.W. 60.53'  
C/L ST. SIGN N.W. 28.7  
C/L STOP SIGN S.S.E. 65.3'  
C/L BLACK TOP S. 15.2'  
C-3 TO C-2 = S00°00'00"W 2639.08'  
C-3 TO B-3 = N86°35'34"W 2635.98'
- 7) KIRK L. VAN ORDER, RECORDED SURVEY, LIBER 1243 PAGE 36, 4/3/87  
FD. ½" RE-ROD  
POWER POLE SW 60.47'  
C/L STOP SIGN SE 65.3'  
WARNING SIGN NE 64.7'  
C/L ST. SIGN NW 28.65'  
CAPPED IRON NW 47.98  
1' NORTH OF N. EDGE ASPHALT RD.
- 8) WIGHTMAN MOORED, INC., BASIL ANDRESS, JR., BOUNDARY SURVEY WITH NOTES, 12-09-92  
FD. ½" IRON  
A-3 TO B-3 = S86°47'45"E 2131.13' (GOV'T 2131.14')  
B-3 TO B-4 = S00°12'23"E 2638.64'
- 9) SECTION CARD  
N ¼ POST BY R. ROON L. 2 P. 94  
FD IRON  
GAS LINE MARKER NNW 31.35  
P POLE SW 60.45  
FOUND IRON  
NAIL P.P. SW 60.45'  
NAIL T.P. NW 33.15'  
GAS LINE MARKER NNW 31.35'