

**SURVEY  
REMONUMENTATION**

APR 29 1999

**SECTION**

**ALLEGAN COUNTY REMONUMENTATION  
LAND CORNER RECORDATION CERTIFICATE  
Filing Requirement of Act 74, Mich. P.A. 1970**

FILED

1/28/1999 2:44:39 PM

JOYCE A. WATTS  
REGISTER OF DEEDS  
ALLEGAN COUNTY, MICH

LIBERO 007 PAGE 033

|  |                   |                  |
|--|-------------------|------------------|
| For corners in<br><u>Allegan</u><br>(County) | Located In:       | Corner Code #    |
| 1. Public Land Survey                        | T4N__ R14W__      | B-11             |
|  | T____ R____       | _____            |
|  | T____ R____       | South 1/4 corner |
|  | T____ R____       | Section 30       |
| 2. Property Controlling<br>in Section        | S____ T____ R____ | Overisel Twp.    |
|  | S____ T____ R____ | _____            |
| 3. Miscellaneous<br>Property in Sec.         | S____ T____ R____ | _____            |
|  | S____ T____ R____ | _____            |
| 4. Lot No. _____, Recorded Plat _____        |                   |                  |
| 5. Private Claims _____                      |                   |                  |

**Register of Deeds Stamp & File Number**

I, Steve Lampen, in a field survey on December 19, 1998, do hereby certify that under requirements of P.A. 74, Michigan P.A. of 1970, the corner points mentioned in lines 1 and 2 above were in conformance with regulations and rules therefore as required in the current manual of survey instructions of the United States Department of the Interior, Bureau of Land Management or by a decree of a Court of Law and/or that the corner points mentioned in lines 3, 4 and 5 above were in conformance with the rules of the Michigan Board of Land Surveyors or by a Decree of a Court of Law; established, re-established, monumented, re-monumented, recovered, found as expressed below:

**NOTE: Not more than 4 corners, all in the same town and range, may be recorded on this certificate.**

A. Description of original monument and accessories and/or subsequent restoration:  
 B-11 Consumers Power Co. - survey - 1968  
 GLO - Britain-Brookfield - 1831-1832 Set iron from old notes  
 Set 1/2 mile post 36" Elm SW 39.6  
 Beech 18 S 7 W 18 Power pole ESE 27.2  
 Beech 4 N 68 W 14 Iron S 47.03  
 L.C.R.C. - L1, P332 - 1972 - Ratekin B-11 to A-11 = 2421.57  
 Found iron B-11 to C-11 = 2646.52  
 B-11 is 3.84' N of A-11 to C-11  
 Centerline N end 12" CMP S 60° E 24.8  
 Power pole S 70° E 27.2  
 Centerline S end 24" CMP S 65° E 26.65  
 5" Cherry S 80° E 52.25  
 Centerline N end 24" CMP N 60° E 29.6


B. Description of corner evidence found and/or method applied in restoring or reestablishing corner:  
 B-11 Found 3/4" iron in monument box Power pole S 70° E 27.2  
 B-11 to a-11 rec. = 2421.57 meas. 2421.84 B-11 to C-11 rec. = 2646.52 meas. = 2646.44  
 B-11 is North of A-11 to C-11 rec. = 3.84 meas. = 4.12

Replaced iron with 3/4"x24" Allegan County Remonumentation iron and cap and accepted it as a careful and Faithful perpetuation of the position of the original corner.

B-11 was approved by the Allegan County Remonumentation Peer Group on December 22, 1998.

**APPROVED REMONUMENTATION CORNER**  
 P.A. 345 OF 1990  
 ALLEGAN COUNTY  
 DATE APPROVED DEC. 22, 1998  
 COUNTY REP. John J. Van Dine

C. Description of monument for corner and accessories established to perpetuate locating the position of the corner:  
 B-11 3/4"x24" Allegan County Remonumentation iron and cap in monument box.  
 Power pole, remonumentation tag in W side 172° 54' 293.66  
 Power pole, remonumentation tag in W side 1° 28' 348.56  
 Power pole, remonumentation tag in N side 113° 38' 27.92  
 10" Ash, remonumentation tag in N side 99° 32' 58.23  
 Centerline N and S asphalt road pavement 270° 3.

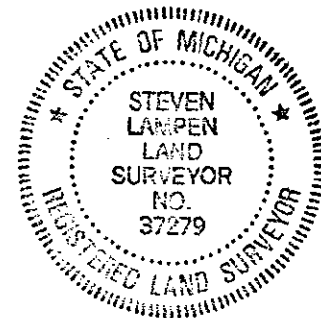

Signed by Steven Lampen

Date JANUARY 11, 1999

Surveyor's Michigan License No. 37279