APR 0 7 1998

Allegan County Remonumentation

AND CORNER	RECORDATION	CERTIFICATE

Filing	Requirem	ent of Act	74, Mich.	P.A. 1970

For	corners SECTION	Filing Requ	irement of A	ct 74, Mich. P.A. 197		) &	
	Allegan	Located In:	Corner	Code ≠≠	Egyh Egisi Acch	JAN	<u>T</u>
1.	Public Land Survey	T 4N R 14W T	Overis	sel Twp.	ء	21 PH 1:2	
	Property Controlling Sin Section S	T R			3	27	
	Miscellaneous S Property in Sec. S	T R T R	-	Re	egister of Deeds St	amp & File I	Number
4. 5.	Lot No, Reco Private Claims	rded Plat			A B C D E	F G H	J K L M
in lia curr Man abov Cou	John C. Bueche, in ereby certify that under require nes 1 and 2 above were in corent manual of survey instructio agement or by a decree of a Core were in conformance with thirt of Law, established, re-esteed below:	ments of P.A. 74, Michigan P nformance with regulations ns of the United States Dep urt of Law and/or that the co e rules of the Michigan Boai	P.A. of 1970, the co and rules (here) partment of the Ir rner points menti rd of Land Survey	orner points mentioned ore as required in the sterior, Bureau of Land oned in lines 3, 4 and 5 rors or by a Decree of a	3 4 7 8 5 5 6 18 17 7 7 8 19 20 9 9 10 10 10 10 10 10 10 10 10 10 10 10 10	-9 -10 15 15 21 22 1 1 1 1 1 1 1 1 1 1 1 1	-1112- -1413- -2324-
NOT	TE: Not more than 4 corne on this certificate.				11 12 -31 -32	-3334	35 36
Α.	Description of original mon C-1 GLO, 1831 Lucius Lyon, DS To N. boundary 155 Lks. W of p Set post cor. Secs. 5&6 Elm 9 S 46 W 2 Elm 10 S 3 E 46	LCRC L2,P379  Frid. iron in Mon Box, April, 1975  ost Stop sign N 45° St. sign S 40° E PK in 6" tree S 4	i. 5 W 25.0 60.0'	Survey MVK July, 1975 Iron in Mon. Box LP NE 118.60 Quad Box Elder	Survey HEI June, 1975 Same wit, as LCRC. L2, P379 OVER		
3.	of Twp., on C/L	nce found and/or metho Dippe in Mon. (with hibit, South & on C/L to Survey, June 1987 (	ole in cover; oit. E-W				

Meas, East to N¼ 5 2669.23' (HEI 1979 2669.35')

Meas. West to N¼ 6 2632.70'

Traverse B-13 to C-13 2634.64'

And is accepted as a careful and faithful perpetuation of the position of the original corner.

Peer group approved May 13, 1997.

APPROVED REMONUMENTATION CORNER
P.A. 345 OF 1990
ALLEGAN COUNTY
DATE APPROVED

5-13-97
COUNTY REP. K.V.O.

C. Description of monument for corner and accessories established to perpetuate locating the position of the corner.

C-1 Placed Allegan Cap in side of pipe in Mon. Box through hole in Box SE cor. brick hse. N 10° W 85.22' SW cor. brick hse. N 34° W 100.89' Nail & Ottawa Tag in W side 14" W. Cherry N 60° E 117.74' Nail & Ottawa Tag in V side PP S 20° E 146.15'
Nail & Allegan Tag in N side 16" Elm S 46° W 89.05'
Ottawa Co. Mon. (SE 31, 5-14) in Mon. Box E 102.24'
On C/L bit. E-W On C/L bit, South




	1122		MANNING		
Signed by	John C Bucke	Date _	10-22-97		
John C. Bueche Surveyor's Michigan License No.	P 13027	·	FORM APPROVED BY MICHIGAN STATE	E BOARD OF LAND SURVEYORS, JAN. 28	

UBIR 0006 PAGE 179

Sheet 1 of 2

Survey Record (cannot read L&P)
K. VanOrder, June, 1997
½" rerod in Mon. Box
C/L stop sign NE 53.56'
C/L N. sign post NE 92.57'
C/L stop sign SE 52.09'
C/L st. sign SW 60.36'

Survey K. VanOrder, April, 1988 Same as above

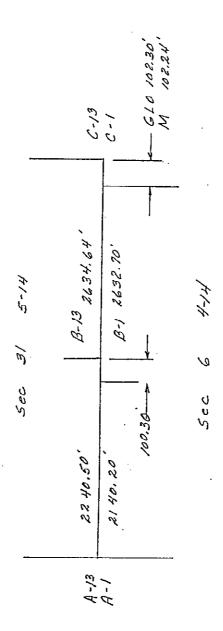


Sheet 2 of 2