

MAR 07 2000

ALLEGAN COUNTY REMONUMENTATION PROGRAM
LAND CORNER RECORDATION CERTIFICATE
Filing Requirement of Act 74, Mich. P.A. 1970

SECTION

For corners in

<u>ALLEGAN</u> (County)	Located In: <u>OVERISEL</u> (Township)	Corner Code #
1. Public Land Survey	<u>T 4N R 14W</u>	<u>C-4</u>
	T ___ R ___	_____
	T ___ R ___	<u>East 1/4 Corner</u>
	T ___ R ___	<u>Section 7</u>
2. Property Controlling in Section	S ___ T ___ R ___	_____
	S ___ T ___ R ___	_____
3. Miscellaneous Property in Sec.	S ___ T ___ R ___	_____
	S ___ T ___ R ___	_____
4. Lot No. _____, Recorded Plat _____		
5. Private Claims _____		

REGISTER OF DEEDS
 ALLEGAN COUNTY, MICH.
 00 FEB - 1 AM 8:49
 FILED
 JAN 07 1999

Register of Deeds Stamp & File Number

I, Robert E. Lemke, surveyor, in a field survey on March 13, 1999 do hereby state that under requirements of P.A. 74, Michigan P.A. of 1970, the corner points mentioned in lines 1 and 2 above were in conformance with regulations and rules therefore as required in the current manual of survey instructions of the United States Department of the Interior, Bureau of Land Management or by a decree of a Court of Law and /or that the corner points mentioned in lines 3, 4 and 5 above were in conformance with the rules of the Michigan Board of Land Surveyors or by a Decree of a Court of Law; established, re-established, monumented, recovered, found as expressed below:

	A	B	C	D	E	F	G	H	I	J	K	L	M
1													
2	6			5		4		3		2		1	
3													
4	7			8		9		10		11		12	
5													
6	10			17		16		15		14		13	
7													
8	19			20		21		22		23		24	
9													
10	30			29		28		27		26		25	
11													
12	31			32		33		34		35		36	
13													

NOTE: Not more than 2 corners, all in the same town and range, may be recorded on this certificate.

A. Description of original monument and accessories and/or subsequent restoration:


SEE BACK OF SHEET FOR CORNER HISTORY

B. Description of corner evidence found and/or method applied in restoring or reestablishing corner:

C-4
FOUND 1" OUTSIDE DIAMETER PINCHED PIPE IN MONUMENT BOX

FOUND P.K. NAIL ON SOUTH SIDE OF WOOD POWER POLE
 FOUND P.K. NAIL ON SOUTH SIDE OF BROKEN WOOD POLE
 FOUND P.K. NAIL ON EAST SIDE OF SUPPORT POLE

SE 71.00'
 ENE 51.92'
 SW 75.27'

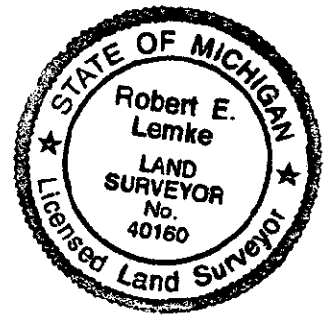

MEASUREMENTS
 C-4 TO B-4 2633.76'(SDI)
 C-4 TO C-5 2644.30'(SDI)
 2632.08'(WATERMAN) 2653.20(WATERMAN)

(DISTANCE TRAVERSED=2644')

ACCEPTED AS A CAREFUL AND FAITHFUL PERPETUATION OF THE POSITION OF THE ORIGINAL CORNER. REPLACED FOUND 1" OUTSIDE DIAMETER PINCHED PIPE WITH A 3/4" X 24" ALLEGAN COUNTY REMONUMENTATION IRON AND CAP #23520 IN MONUMENT BOX.

PEER GROUP APPROVED MAY 11, 1999.

C. Description of monument for corner and accessories established to perpetuate locating the position of the corner:

C-4
SET 3/4" x 24" ALLEGAN COUNTY REMONUMENTATION IRON AND CAP #23520 IN MONUMENT BOX

SET P.K. NAIL WITH ALLEGAN CO. REMON. TAG 1' EAST OF WEST EDGE OF ASPHALT 46 TH ST	N	57.70'
MEASURED TO CENTER OF YELLOW GAS PIPELINE MARKER	N36°E	55.25'
SET NAIL WITH ALLEGAN CO. REMON. TAG ON S.E. SIDE OF BROKEN WOOD POLE 12" ABOVE GROUND	N66°E	51.87'
SET NAIL WITH ALLEGAN CO. REMON. TAG ON EAST SIDE OF WOOD SUPPORT POLE 30" ABOVE GROUND	S12°W	75.17'
SET NAIL WITH ALLEGAN CO. REMON. TAG ON WEST SIDE OF WOOD POWER POLE 24" ABOVE GROUND	S31°E	70.41'

MONUMENT IS 4' EAST OF WEST EDGE OF ASPHALT OF 46TH ST; 6.8' WEST OF THE CENTERLINE OF 46TH ST. AND 1'+/- SOUTH OF THE CENTERLINE OF 145TH AV.

Signed by Robert E. Lemke
 For SDI CONSULTANTS, LTD

Date 12/30/1999

Surveyor's Michigan License No.40160

SHEET 1 OF 2

APPROVED REMONUMENTATION CORNER
 P.A. 345 OF 1990
 ALLEGAN COUNTY
 DATE APPROVED MAY 11, 1999
 COUNTY REP. [Signature]

FORM APPROVED BY MICHIGAN STATE BOARD OF PROFESSIONAL SURVEYORS
 JAN. 26, 1971 REVISED MAY 14, 1975
 REVISED JAN., 1983
 REVISED OCT., 1995

