

COMMISSION  
For corners in


ALLEGAN COUNTY REMONUMENTATION  
LAND CORNER RECORDATION CERTIFICATE  
Filing Requirement of Act 74, Mich. P.A. 1970

1993 DEC 30 PM 2:45  
REGISTER OF DEEDS  
ALLEGAN COUNTY, MICH.  
Jasper A. Cobble  
FILED  
Register of Deeds Stamp & File Number

Allegan (County)	Located In:	Corner Code #
1. Public Land Survey	T <u>4N</u> R <u>14W</u>	<u>D-7 (N-1/4 Sec 20)</u>
	T _____ R _____	<u>Ovenset Twp.</u>
	T _____ R _____	_____
	T _____ R _____	_____
2. Property Controlling in Section	S _____ T _____ R _____	_____
	S _____ T _____ R _____	_____
3. Miscellaneous Property in Sec.	S _____ T _____ R _____	_____
	S _____ T _____ R _____	_____

- 4. Lot No. \_\_\_\_\_, Recorded Plat \_\_\_\_\_
- 5. Private Claims \_\_\_\_\_

I, Gerald T. Ford, in a field survey on November 17, 1993, do hereby certify that under requirements of P.A. 74, Michigan P.A. of 1970, the corner points mentioned in lines 1 and 2 above were in conformance with regulations and rules therefore as required in the current manual of survey instructions of the United States Department of the Interior, Bureau of Land Management or by a decree of a Court of Law and/or that the corner points mentioned in lines 3, 4 and 5 above were in conformance with the rules of the Michigan Board of Land Surveyors or by a Decree of a Court of Law: established, re-established, monumented, re-monumented, recovered, found as expressed below:

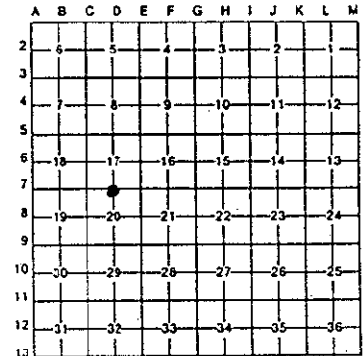

NOTE: Not more than 4 corners, all in the same town and range, may be recorded on this certificate.

A. Description of original monument and accessories and/or subsequent restoration:

D-7	Consumers Power Co. witnesses (Drawing No S-F16897)
Government Land Office Survey Notes	Iron
20" Beech for corner No witnesses	Street Sign NW 31.60'
	24" Hickory SW 44.70'
	Fence Corner SW 53.00'
	CL Road N 2.00'
	Power Pole SE 80.85'
	NW Cor Sec 20T4N R14W W 2653.66'
	Center Sec 20, T4N R14W S 2651.05'

B. Description of corner evidence found and/or method applied in restoring or reestablishing corner:


D-7  
Found angle iron monument box and accepted it as a careful and faithful perpetuation of the position of the original corner

CL Road	N	2.20'
Meas. dist to NW Cor Sec 20, Found Steel Bar	W	2653.79'
Meas. dist to Center Sec 20, A.C. Mon.	S	2651.29'

C. Description of monument for corner and accessories established to perpetuate locating the position of the corner:

D-7  
Replaced iron in monument box with A. C. Remonumentation Iron & Cap

A.C. Remon tag & nail in E face of power pole	AZ.	141°	79.49'
A.C. Remon tag & nail in E face of fence post	AZ.	203°	62.39'
A.C. Remon tag & nail in W face of power pole	AZ.	218°	79.55'
A.C. Remon tag & nail in NW face of fence post	AZ.	243°	69.36'
A.C. Remon tag & nail in SE face 20" Elm	AZ.	295°	191.37'
CL Bituminous Road	AZ.	00°	2.2'

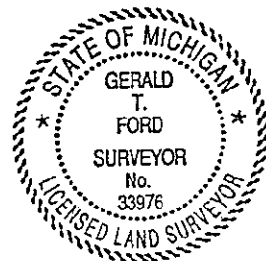

Signed by Gerald T. Ford Date December 21, 1993

Surveyor's Michigan License No. 33976

FORM APPROVED BY MICHIGAN STATE BOARD OF LAND SURVEYORS, JAN. 28, 1971  
REVISED MAY 14, 1975  
REVISED JAN., 1983