

**ALLEGAN COUNTY REMONUMENTATION**  
**LAND CORNER RECORDATION CERTIFICATE**  
 Filing Requirement of Act 74, Mich. P.A. 1970

For corners in

<u>Allegan</u> <small>(County)</small>	Located In:	Corner Code <del>##</del>
1. Public Land Survey	T <u>4N</u> R <u>14W</u>	<u>E-2 (W. 1/4 Sec. 4)</u>
	T <u>    </u> R <u>    </u>	<u>Overisel-Twp.</u>
	T <u>    </u> R <u>    </u>	_____
	T <u>    </u> R <u>    </u>	_____
2. Property Controlling in Section	S <u>    </u> T <u>    </u> R <u>    </u>	_____
	S <u>    </u> T <u>    </u> R <u>    </u>	_____
3. Miscellaneous Property in Sec.	S <u>    </u> T <u>    </u> R <u>    </u>	_____
	S <u>    </u> T <u>    </u> R <u>    </u>	_____


1993 DEC 30 PM 2:45  
 REGISTER OF DEEDS  
 ALLEGAN COUNTY, MICHIGAN  
*Gregory A. Bellis*

FILED

Register of Deeds Stamp & File Number

4. Lot No. \_\_\_\_\_, Recorded Plat \_\_\_\_\_  
 5. Private Claims \_\_\_\_\_

I, Gerald T. Ford, in a field survey on November 18, 1993, do hereby certify that under requirements of P.A. 74, Michigan P.A. of 1970, the corner points mentioned in lines 1 and 2 above were in conformance with regulations and rules therefore as required in the current manual of survey instructions of the United States Department of the Interior, Bureau of Land Management or by a decree of a Court of Law and/or that the corner points mentioned in lines 3, 4 and 5 above were in conformance with the rules of the Michigan Board of Land Surveyors or by a Decree of a Court of Law; established, re-established, monumented, re-monumented, recovered, found as expressed below:

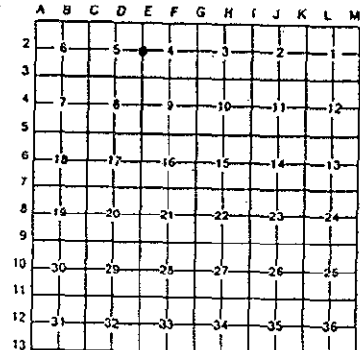

NOTE: Not more than 4 corners, all in the same town and range, may be recorded on this certificate.

A. Description of original monument and accessories and/or subsequent restoration:

E-2-1831		E-2	
Government Land Office Survey Notes		Recorded in Liber 2, Page 373, March 26, 1975	
Post		Iron over stone	
20" Maple	N22°E	23 links	15" Cherry
12" Beech	S15°W	16 links	WSW
			97.54'
			S End N-S Culvert
			SSE
			18.23'
			N End N-S Culvert
			NNE
			21.50'
			4-3" Maple
			SE
			32.45'


C.P. Co. (Drawing No SF-17935)  
 Cen. Sec 4, T4N R15W      E      2662.66  
 Deflection of Sec line at Center, Sec 4 is 00°06'50" North

B. Description of corner evidence found and/or method applied in restoring or reestablishing corner:

E-2  
 Found 3/4" steel bar in monument box and accepted it as a careful and faithful perpetuation of the position of the original corner.  
 Meas. dist. to Center, Sec. 4, Found steel bar in monument box      E      2662.65'  
 Meas. deflection of Sec. line at Center, Sec 4 is 00°06'51" North

C. Description of monument for corner and accessories established to perpetuate locating the position of the corner:

E-2	
Set Allegan County Remonumentation Iron & Cap in place of steel bar in monument box	
A.C. Remon tag & nail in E face 12" Elm	AZ. 168° 58.95'
"X" cut in top of N end 18" CMP Culvert	AZ. 12° 24.90'
"X" cut in top of S end 18" CMP Culvert	AZ. 169° 24.77'
A.C. Remon tag & nail in SE face of Power Pole	AZ. 234° 76.45'
SE Cor of Conc. Blk. House Fnd. (1' above grd)	AZ. 322° 110.23'

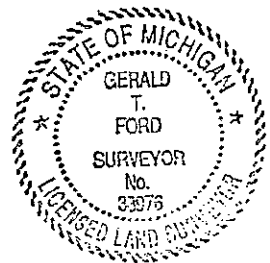

Signed by Gerald T. Ford Date December 21, 1993  
 Surveyor's Michigan License No. 33976