

# REMONUMENTATION

APR 25 1995

## COMMISSION

### ALLEGAN COUNTY REMONUMENTATION LAND CORNER RECORDATION CERTIFICATE Filing Requirement of Act 74, Mich. P.A. 1970

For corners in

Allegan (County)	Located In:	Corner Code #
1. Public Land Survey	T <u>4N</u> R <u>14W</u>	<u>E-10</u>
	T ___ R ___	<u>W 1/4 Cor.</u>
	T ___ R ___	<u>Sec. 28</u>
	T ___ R ___	<u>E 1/4 Cor.</u>
2. Property Controlling in Section	S ___ T ___ R ___	<u>Sec. 29</u>
	S ___ T ___ R ___	<u>Overisel Twp.</u>
3. Miscellaneous Property in Sec.	S ___ T ___ R ___	_____
	S ___ T ___ R ___	_____

1994 DEC 30 PM 12:18  
 REGISTER OF DEEDS  
 ALLEGAN COUNTY MICHIGAN  
*Joyce L. Patton*


FILED

Register of Deeds Stamp & File Number

4. Lot No. \_\_\_\_\_, Recorded Plat \_\_\_\_\_  
 5. Private Claims \_\_\_\_\_

I, Kirk Van Order, in a field survey on May 20, 19 94, do hereby certify that under requirements of P.A. 74, Michigan P.A. of 1970, the corner points mentioned in lines 1 and 2 above were in conformance with regulations and rules therefore as required in the current manual of survey instructions of the United States Department of the Interior, Bureau of Land Management or by a decree of a Court of Law and/or that the corner points mentioned in lines 3, 4 and 5 above were in conformance with the rules of the Michigan Board of Land Surveyors or by a Decree of a Court of Law; established, re-established, monumented, re-monumented, recovered, found as expressed below:

NOTE: Not more than 4 corners, all in the same town and range, may be recorded on this certificate.

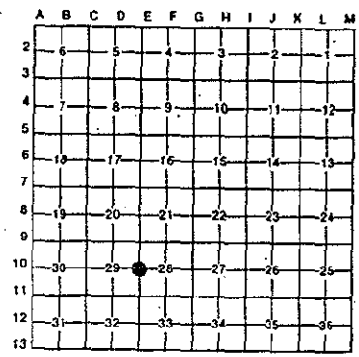

A. Description of original monument and accessories and/or subsequent restoration:

- E-10  
 •GLO set post at 40.00 chains North of E-11.  
 10" Beech N 22°W 23 links  
 9" Dogwood S 52°E 16 links  
 •No recorded LCRC

APPROVED REMONUMENTATION CORNER  
 P.A. 345 OF 1990  
 ALLEGAN COUNTY  
 DATE APPROVED 8-9-94  
 COUNTY REP. Kirk L. Van Order

(Continued on back of sheet)

B. Description of corner evidence found and/or method applied in restoring or reestablishing corner:

- E-10  
 Set capped iron midway and on line between E-11 and E-9 on June 14, 1984.  
 Fd. capped iron using witnesses shown on June 14, 1984 survey.  
 C/L Road to South E 4' +/-  
 C/L E & W Road N 13'  
 E-9 North 2656.37'  
 E-11 South 1656.37'

And is accepted as a careful and faithful perpetuation of the position of the original corner.

Peer Group approved 8-9-94.

C. Description of monument for corner and accessories established to perpetuate locating the position of the corner:

- E-10  
 Removed capped iron and set standard Allegan Co. Remon. monument (3/4" x 36" steel rod w/red cap #23520)  
 Nail & Remon. tag in SE corner guardrail post S,SW 54.89'  
 Nail & Remon. tag in SE corner guardrail post SW 59.68'  
 C/L Tele. Pedestal W,SW 36.29'  
 Nail & Remon. tag in NW side 9" Twin Boxelder N,NE 150.87'  
 C/L gas pipeline vent pipe NE 57.39'

Signed by *Kirk L. Van Order* Date 12-30-94  
 Surveyor's Michigan License No. 23520

LIBR 0005 PAGE 152

