


ALLEGAN COUNTY REMONUMENTATION  
 LAND CORNER RECORDATION CERTIFICATE  
 Filing Requirement of Act 74, Mich. P.A. 1970

For corners in

<u>Allegan</u> County	Located in:	Corner Code #
1. Public Land Survey	T <u>4N</u> R <u>14W</u>	<u>F-12</u>
	T ___ R ___	<u>Center</u>
	T ___ R ___	<u>Sec. 33</u>
	T ___ R ___	<u>Overisel Twp.</u>
Property Controlling in Section	S ___ T ___ R ___	
	S ___ T ___ R ___	
3. Miscellaneous Property in Sec.	S ___ T ___ R ___	
	S ___ T ___ R ___	
4. Lot No. _____, Recorded Plat _____		
5. Private Claims _____		

1995 DEC 14 PM 2:36  
 REGISTER OF DEEDS  
 ALLEGAN COUNTY, MICHIGAN  
 Register of Deeds Stamp & File Number

**SURVEY &  
 REMONUMENTATION  
 APR 29 1996  
 COMMISSION**

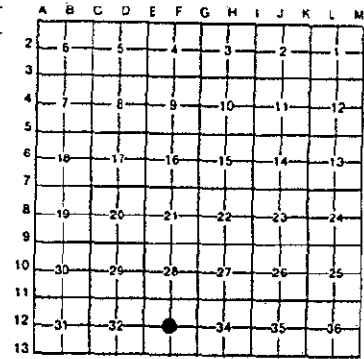

I, Kirk L. Van Order in a field survey on April 13, 19 95, do hereby certify that under requirements of P.A. 74, Michigan P.A. of 1970, the corner points mentioned in lines 1 and 2 above were in conformance with regulations and rules therefore as required in the current manual of survey instructions of the United States Department of the Interior, Bureau of Land Management or by a decree of a Court of Law and/or that the corner points mentioned in lines 3, 4 and 5 above were in conformance with the rules of the Michigan Board of Land Surveyors or by a Decree of a Court of Law; established, re-established, monumented, re-monumented, recovered, found as expressed below:

NOTE: Not more than 4 corners, all in the same town and range, may be recorded on this certificate.

A. Description of original monument and accessories and/or subsequent restoration:

F-12

- Not set by GLO
- T.O. Williams 1889 survey indicated stake at corner
  - 40.76 1/2 chains to N 1/4 corner
  - 39.8 chains to E 1/4 corner
  - 40.52 chains to S 1/4 corner
  - 39.9 chains to W 1/4 corner

(continued on back of sheet)

B. Description of corner evidence found and/or method applied in restoring or reestablishing corner:

F-12

- Kirk L. Van Order survey dated April 13, 1995
- Fd. 1" I.D. pipe over 1/2" re-rod in mon. box
- Ties taken Mar. 14, 1989 checked
- N00°12'29"W 2690.49' to N 1/4 corner
- S89°16'24"E 2624.08' to E 1/4 corner
- S00°51'37"E 2670.89 to S 1/4 corner (computed position)
- N89°13'49"W 2637.60 to W 1/4 corner

APPROVED REMONUMENTATION CORNER  
 P.A. 345 OF 1990  
 ALLEGAN COUNTY  
 DATE APPROVED 12-5-95  
 COUNTY REP. [Signature]


This position not established by original government surveyors. This monument is accepted as the best available evidence of the position of the corner.

C. Description of monument for corner and accessories established to perpetuate the position of the corner.

F-12

- Removed pipe and iron and set standard Allegan Co. Remon. monument (3/4" x 24" steel rod w/red cap #23520) in monument box
- Nail & Remon. tag N side power pole AZ. 254°59' 104.98'
- Nail & Remon. tag NE side power pole AZ. 302°45' 118.62'
- Nail & Remon. tag NW side power pole AZ. 67°26' 152.26'
- NE cor. conc. block house foundation AZ. 165°49' 163.64'

Signed by [Signature] Date 12-13-95  
 Surveyor's Michigan License No. 23520

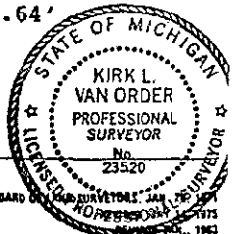

Section A (continued from Page 1)

F-12

- Early 1900 notes Hugh McDougall
  - Ties to corner
  - Maple 12" SE 97.5'
  - Maple 8" S 135'
- D.A. Ratekin July 16, 1964 survey
  - Fd. center but does not show what was found or ties to corner
- LCRC (L. 3, P. 332) John Clapp, Mar. 10, 1982
  - Fd. iron in monument box
  - Nail in 48" Maple SE 98.52'
  - Nail in power pole E,NE 152.31'
  - Nail in power pole W,SW 104.96'
  - Nail in power pole W,NW 118.50'
- Kirk Van Order survey Mar. 14, 1989
  - Fd. 1/2" iron in monument box
  - 39" Maple SE 98.10'
  - Power pole E,NE 152.30'
  - Power pole W,SW 105.00'
  - Power pole W,NW 118.61'
- Kirk Van Order survey Mar. 16, 1989 (same as above)
- Kirk Van Order survey June 24, 1993 corner (same as above)