

**SURVEY
REMONUMENTATION**

APR 29 1999

SECTION

**ALLEGAN COUNTY REMONUMENTATION
LAND CORNER RECORDATION CERTIFICATE
Filing Requirement of Act 74, Mich. P.A. 1970**

For corners in

<u>Allegan</u> (County)	Located in:	Corner Code #
1. Public Land Survey	T <u>4</u> N R <u>14</u> W	<u>H-13</u>
	T ___ R ___	<u>Overisel</u> Twp.
	T ___ R ___	_____
	T ___ R ___	_____
2. Property Controlling in Section	S ___ T ___ R ___	_____
	S ___ T ___ R ___	_____
3. Miscellaneous Property in Sec.	S ___ T ___ R ___	_____
	S ___ T ___ R ___	_____

FILED
1/28/1999 2:44:39 PM
JOYCE A. WATTS
REGISTER OF DEEDS
ALLEGAN COUNTY, MICH

Register of Deeds Stamp & File Number

LIBERO 007 PAGE 1,0

4. Lot No. _____, Recorded Plat _____
5. Private Claims _____

I, Kirk L. Van Order, in a field survey on June 12, 19 98 do hereby state that under requirements of P.A. 74, Michigan P.A. of 1970, the corner points mentioned in lines 1 and 2 above were in conformance with regulations and rules therefore as required in the current manual of survey instructions of the United States Department of the Interior, Bureau of Land Management or by a decree of a Court of Law and/or that the corner points mentioned in lines 3, 4 and 5 above were in conformance with the rules of the Michigan Board of Land Surveyors or by a Decree of a Court of Law; established, re-established, monumented, recovered, found as expressed below:

NOTE: Not more than 2 corners, all in the same town and range, may be recorded on this certificate.

	A	B	C	D	E	F	G	H	I	J	K	L	M
1													
2		6		5		4		3		2		1	
3													
4		7		8		9		10		11		12	
5													
6		18		17		16		15		14		13	
7													
8		19		20		21		22		23		24	
9													
10		30		29		28		27		26		25	
11													
12		31		32		33		34		35		36	
13													

A. Description of original monument and accessories and/or subsequent restoration:

H-13
(1) GLO
West S. side Sec. 34
40.00 set quarter section post
Maple 4" N59°E 20
B. Oak 7" N66-1/2°W 29

(continued on back of sheet)

B. Description of corner evidence found and/or method applied in restoring or reestablishing corner:

H-13
Fd. concrete monument 4" in dia. x 36" long with 1/2" dia. steel re-rod protruding from top and the following accessories as listed in No. 2 above. And is accepted as a careful and faithful perpetuation of the position of the original corner.

Peer group approved Sept. 8, 1998.

Traversed distance = 2636.70 feet off road.


APPROVED REMONUMENTATION CORNER
P.A. 345 OF 1990
ALLEGAN COUNTY
DATE APPROVED SEPT. 8, 1998
COUNTY REP. [Signature]

C. Description of monument for corner and accessories established to perpetuate locating the position of the corner:

H-13
Affixed standard Allegan County Remon. red plastic cap to top of re-rod in concrete monument

Nail & Remon. tag in SW side 11" ash	AZ 165°	19.58'
Nail & Remon. tag in E side 13" elm	AZ 195°	27.27'
Nail & Remon. tag in SE side 14" butternut	AZ 225°	28.40'
Nail & Remon. tag in E side 9" ash	AZ 10°	10.87'
H-1, T.3N., R.14W.	S89°22'52"E	19.10'
G-1, T.3N., R.14W.	N89°22'48"W	2586.63'

Signed by [Signature]
Surveyor's Michigan License No. 23520

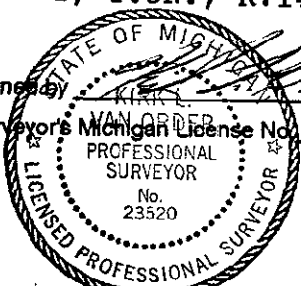

Date 12-23-98

APR 29 1988

SECTION

LIBER 007 PAGE 41

Section A - (continued from Page 1)

H-13

Overisel Twp., T.1N., R.14W.

- (2) LCRC by David R. Greer dated Nov. 1984, recorded in Liber 003, Page 368
Set concrete monument 4" x 36" on line and midway between G-13 & I-13
10" tree NE 49.10'
12" cherry W,SW 20.32'
12" tree S,SW 27.23'
(concrete monument East 19.20'
T.3N., R.14W.)