

LAND CORNER RECORDATION CERTIFICATE
Filing Requirement of Act 74, Mich. P.A. 1970

For corners in

| | | |
|---------------------------------------|--------------------------|----------------------|
| <u>Allegan</u> County | Located In: | Corner Code # |
| 1. Public Land Survey | T <u>4N</u> R <u>14W</u> | <u>I-10</u> |
| | T ___ R ___ | <u>W 1/4 Cor.</u> |
| | T ___ R ___ | <u>Sec. 26</u> |
| | T ___ R ___ | <u>E 1/4 Cor.</u> |
| 2. Property Controlling in Section | S ___ T ___ R ___ | <u>Sec. 27</u> |
| | S ___ T ___ R ___ | <u>Overisel Twp.</u> |
| 3. Miscellaneous Property in Sec. | S ___ T ___ R ___ | _____ |
| | S ___ T ___ R ___ | _____ |

1995 DEC 14 PM 2:36
 REGISTER OF DEEDS
 ALLEGAN COUNTY
 Register of Deeds Stamp & File Number

FILED

**SURVEY &
 REMONUMENTATION**

APR 29 1996

COMMISSION

4. Lot No. _____, Recorded Plat _____
 5. Private Claims _____

| A | B | C | D | E | F | G | H | I | J | K | L | M |
|----|----|----|----|----|----|----|---|---|---|---|---|---|
| 2 | 6 | 5 | 4 | 3 | 2 | 1 | | | | | | |
| 3 | | | | | | | | | | | | |
| 4 | 7 | 8 | 9 | 10 | 11 | 12 | | | | | | |
| 5 | | | | | | | | | | | | |
| 6 | 15 | 17 | 16 | 15 | 14 | 13 | | | | | | |
| 7 | | | | | | | | | | | | |
| 8 | 19 | 20 | 21 | 22 | 23 | 24 | | | | | | |
| 9 | | | | | | | | | | | | |
| 10 | 30 | 29 | 28 | 27 | 26 | 25 | | | | | | |
| 11 | | | | | | | | | | | | |
| 12 | 31 | 32 | 33 | 34 | 35 | 36 | | | | | | |
| 13 | | | | | | | | | | | | |

I, Kirk L. Van Order, in a field survey on March 28, 1995, do hereby certify that under requirements of P.A. 74, Michigan P.A. of 1970, the corner points mentioned in lines 1 and 2 above were in conformance with regulations and rules therefore as required in the current manual of survey instructions of the United States Department of the Interior, Bureau of Land Management or by a decree of a Court of Law and/or that the corner points mentioned in lines 3, 4 and 5 above were in conformance with the rules of the Michigan Board of Land Surveyors or by a Decree of a Court of Law, established, re-established, monumented, re-monumented, recovered, found as expressed below.

NOTE: Not more than 4 corners, all in the same town and range, may be recorded on this certificate.

A. Description of original monument and accessories and/or subsequent restoration:

- I-10
 ●GLO set 1/4 section post
 Beech 10 S67W 12
 Do 12 N69E 32
 ●Hugh McDougall survey dated Apr. 26 & 27, 1905
 Set stone on line and equidistant from section corner
 Fd. all other government corners in Section 26
 ●Hugh McDougall survey dated May 1, 1905 (continued on back)
 Fd. all government corners, put in rest as above
 May 11, 1905 copy of min. survey recorded in reg. of deeds office

B. Description of corner evidence found and/or method applied in restoring or reestablishing corner:

I-10
 Kirk L. Van Order, Mar. 28, 1995
 Fd. 0.05' x 0.5' steel rod in mon. box by using ties from survey dated Dec. 21, 1983

And is accepted as a careful and faithful perpetuation of the position of the original corner.


Peer group approved Sept. 12, 1995.

APPROVED REMONUMENTATION CORNER
 P.A. 345 OF 1990
 ALLEGAN COUNTY
 DATE APPROVED 9-12-95
 COUNTY REP. Kirk L. Van Order

C. Description of monument for corner and accessories established to perpetuate locating the position of the corner:

I-10
 Removed steel rod and set standard Allegan Co. Remon. monument (3/4" x 36" steel rod w/red cap #23520)
 Nail & Remon. tag W side power pole AZ. 171°08' 229.62'
 Nail & Remon. tag SE side power pole AZ. 190°24' 254.64'
 Nail & Remon. tag NW side power pole AZ. 232°47' 58.74'
 Nail & Remon. tag E side power pole AZ. 346°12' 209.62'

Signed by [Signature] Date 12-13-95
 Surveyor's Michigan License No. 23520

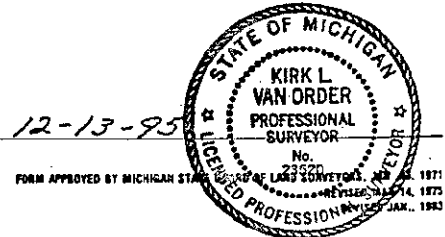

FORM 0005 PAGE 281

Section A, I-10 (continued from Page 1)

●D.A. Ratekin & Assoc., Inc. 1972 survey

Fd. pipe

LCRC, L. 1, P. 385, dated July 28-1972

●D.A. Ratekin

Fd. stone and 1-1/4" x 18" pipe (all LCRC witnesses gone except

Power pole S51°W 58.85')

●Russel Roon LCRC, L. 02, P. 102, dated Aug. 2, 1973

Set steel bar from Co. Road Comm. & Co. surveyor witnesses

●Kirk L. Van order survey dated Dec. 21, 1983, L. 1074, P. 250

Fd. steel rod in mon. box (Power pole SW 58.72')

●Kirk L. Van Order survey dated July 10, 1990

Fd. steel rod in mon. box

●Kirk L. Van Order survey dated Mar. 14, 1994

Fd. steel rod in mon. box