

**SURVEY  
REMONUMENTATION**

APR 29 1999

**ALLEGAN COUNTY REMONUMENTATION  
LAND CORNER RECORDATION CERTIFICATE  
Filing Requirement of Act 74, Mich. P.A. 1970**

LIBERO 007 PAGE 48

**SECTION**

For corners in

<u>Allegan</u> (County)	Located In:	Corner Code #
1. Public Land Survey	T4N R 14W	L-13
	T___ R___	Overisel Twp.
	T___ R___	_____
	T___ R___	_____
2. Property Controlling in Section	S___ T___ R___	_____
	S___ T___ R___	_____
3. Miscellaneous Property in Sec.	S___ T___ R___	_____
	S___ T___ R___	_____

FILED  
1/28/1999 2:44:39 PM

JOYCE A. WATTS  
REGISTER OF DEEDS  
ALLEGAN COUNTY, MICH

Register of Deeds Stamp & File Number

4. Lot No. \_\_\_\_\_, Recorded Plat \_\_\_\_\_  
5. Private Claims \_\_\_\_\_

I, Kirk L. Van Order, in a field survey on June 6, 1998 do hereby state that under requirements of P.A. 74, Michigan P.A. of 1970, the corner points mentioned in lines 1 and 2 above were in conformance with regulations and rules therefore as required in the current manual of survey instructions of the United States Department of the Interior, Bureau of Land Management or by a decree of a Court of Law and/or that the corner points mentioned in lines 3, 4 and 5 above were in conformance with the rules of the Michigan Board of Land Surveyors or by a Decree of a Court of Law; established, re-established, monumented, recovered, found as expressed below:

A	B	C	D	E	F	G	H	I	J	K	L	M
1												
2	6	5	4		3		2		1			
3												
4	7	8	9		10		11		12			
5												
6	18	17	16		15		14		13			
7												
8	19	20	21		22		23		24			
9												
10	30	29	28		27		26		25			
11												
12	31	32	33		34		35		36			
13												

NOTE: Not more than 2 corners, all in the same town and range, may be recorded on this certificate.

A. Description of original monument and accessories and/or subsequent restoration:

- L-13  
(1) GLO  
West on S. side Section 36  
40.00 chains set quarter section post  
Beech 6" N45°E 19 links  
Beech 7" N65°W 43 links  
(2) A. Gardner Co. Surveyor Feb. 25, 1880  
Stone at corner.

(continued on back of sheet)

B. Description of corner evidence found and/or method applied in restoring or reestablishing corner:

- L-13  
Fd. RR spike and the following accessories:  
SW cor. house fndn. NE 100.40'  
Power pole SE 96.12'  
Tel. pole SE 78.20'  
40" tree N 21.77'

APPROVED REMONUMENTATION CORNER  
P.A. 345 OF 1990  
ALLEGAN COUNTY  
DATE APPROVED JULY 14, 1998  
COUNTY REP. [Signature]

Field line to North  
Set L-13 midway and on line between K-13 and M-13 and is accepted as a careful and faithful perpetuation of the position of the original corner. Peer group approved July 14, 1998.


C. Description of monument for corner and accessories established to perpetuate locating the position of the corner:  
Traversed distance = 5275.15 feet on road.

- L-13  
Removed RR spike and set standard Allegan Co. Remon. monument (3/4" x 24" steel rod w/red cap #23520)  
Nail & Remon. tag in NW side 15" maple AZ 40°17' 72.68'  
Nail & Remon. tag in E side 14" elm AZ 08°07' 57.95'  
Nail & Remon. tag in N side power pole AZ 254°18' 245.94'  
Nail & Remon. tag in SW side power pole AZ 138°53' 96.06'  
SW corner conc. block house fndn. AZ 41°07' 100.46'  
C/L asphalt road AZ 180° 0.5'

(continued on back of sheet)

Signed by \_\_\_\_\_  
Surveyor's Michigan License No. \_\_\_\_\_

Date 12-23-98

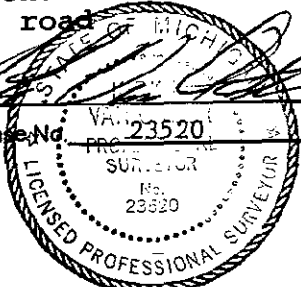

SURVEY  
REMONUMENTATION

APR 29 1988

SECTION

LIBERO 007 PAGE 4, 9

Section A (continued from Page 1)

L-13

Overisel Twp., T.4N., R15W.

(Continued No. 2)

39.95 chains V 2°-40' to SE corner Sec. 36

40.00 chains V 2°-35' to SW corner Sec. 36

V 4°-37' N & S 1/4 line

- (3) Kirk L. Van Order recorded survey, Liber 1074, Page 252, dated Apr. 24, 1984

Set RR spike at corner midway and on line between SW and SE corner of Section 36

SW cor. house fndn.	NE	100.40'
Tel. pole	SE	78.20'
Power pole	SE	96.12'
40" tree	N	21.77'

Field line to the North

Due West 2637.72' from SE corner Sec. 36

- (4) Kirk L. Van Order recorded survey, Liber 1186, Page 171, dated Feb. 14, 1986

Fd. RR spike at corner

(Same tie info. as in No. 3)

Section C

K-13	AZ 270°	2637.575'
M-13	AZ 90°	2637.575'