

**SURVEY
REMONUMENTATION**

APR 29 1998

SECTION

**Allegan County Remonumentation
LAND CORNER RECORDATION CERTIFICATE
Filing Requirement of Act 74, Mich. P.A. 1970**

For corners in

Allegan
(County)

Located In:

Corner Code #

1. Public Land Survey

T 4N R 14W M-4 (E 1/2, 12)
Overisel Twp.

2. Property Controlling
in Section

S T R
S T R
S T R
S T R

3. Miscellaneous
Property in Sec.

4. Lot No. _____, Recorded Plat _____
5. Private Claims _____

I, John C. Bueche, in a field survey on May 8, 1998 do hereby state that under requirements of P.A. 74, Michigan P.A. of 1970, the corner points mentioned in lines 1 and 2 above were in conformance with regulations and rules therefore as required in the current manual of survey instructions of the United States Department of the Interior, Bureau of Land Management or by a decree of a Court of Law and /or that the corner points mentioned in lines 3, 4 and 5 above were in conformance with the rules of the Michigan Board of Land Surveyors or by a Decree of a Court of Law; established, re-established, monumented, recovered, found as expressed below:

NOTE: Not more than 2 corners, all in the same town and range, may be recorded on this certificate.

- A. Description of original monument and accessories and/or subsequent restoration:
- M-4 GLO, 1831
 - Lucius Lyon, DS
 - Set gr. Sec. post
 - Beech 4 S 29 W 22
 - Maple 30 N 29 W 39
 - LCRC 2-87, Jan., 1973, Clapp
 - Set iron
 - 36" Oak E 20.67'
 - Iron W 33.00'
 - Iron S 11.07' (Salem Cor.)
 - PP SE 45.25'
 - 12" Tw. Oak W 18.72'
 - 16" Oak WNW 46.30'
 - South 2641.52'

APPROVED REMONUMENTATION CORNER
P.A. 345 OF 1990
ALLEGAN COUNTY
DATE APPROVED JUNE 9 1998
COUNTY REP. [Signature]


B. Description of corner evidence found and/or method applied in restoring or reestablishing corner:

M-4 Found 1/2" x 36" rod in gravel road
36" Oak E 20.67'±
PP SE 45.25'
Iron S 11.07' (Salem Cor.) Peer group approved 6-9-98.

And is accepted as a careful and faithful perpetuation of the position of the original corner.

C. Description of monument for corner and accessories established to perpetuate locating the position of the corner:

M-4 Replaced 1/2" rod with 3/4" x 24" Pin with Allegan Co. Cap in gravel road
Nail & Allegan Co. Remon. Tag in NE side PP S 40° W 45.67'
Nail & Allegan Co. Remon. Tag in S side 16" Oak S 90° W 53.71'
Nail & Allegan Co. Remon. Tag in SW side 10" Elm N 30° W 56.90'
Nail & Allegan Co. Remon. Tag in E side 8" Walnut N 40° E 43.41'
Allegan Co. Mon. A-4 (W 1/4 7, 4-13) South 11.07'
C/L gravel road N-S is West 3'±
On South edge woods West; C/L drive East is South 50'±

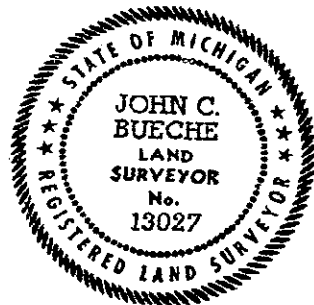

Signed by John C. Bueche
Surveyor's Michigan License No. 13027

Date 6-4-98

Register of Deeds Stamp & File Number

	A	B	C	D	E	F	G	H	I	J	K	L	M	
1														
2	6			5			4			3			2	1
3														
4	7			8			9			10			11	12
5														
6	18			17			16			15			14	13
7														
8	19			20			21			22			23	24
9														
10	30			29			28			27			26	25
11														
12	31			32			33			34			35	36
13														

LIBR00007 PAGE 51