

**SURVEY  
REMONUMENTATION**

APR 29 1998

**SECTION**

**Allegan County Remonumentation  
LAND CORNER RECORDATION CERTIFICATE  
Filing Requirement of Act 74, Mich. P.A. 1970**

For corners in

<u>Allegan</u> (County)	Located In:	Corner Code #
1. Public Land Survey	T4N R14W	M-5 (SE, 12)
	T R	Overisel Twp.
	T4N R13W	A-5 (NW 18)
	T R	Salem Twp.
2. Property Controlling in Section	S T R	
	S T R	
3. Miscellaneous Property in Sec.	S T R	
	S T R	

FILED  
1/28/1999 2:44:39 PM  
JOYCE A. WATTS  
REGISTER OF DEEDS  
ALLEGAN COUNTY, MICH  
  
Register of Deeds Stamp & File Number

LIBR0007 PAGE 59

4. Lot No. \_\_\_\_\_, Recorded Plat \_\_\_\_\_  
5. Private Claims \_\_\_\_\_

I, John C. Bueche, in a field survey on May 8, 1998 do hereby state that under requirements of P.A. 74, Michigan P.A. of 1970, the corner points mentioned in lines 1 and 2 above were in conformance with regulations and rules therefore as required in the current manual of survey instructions of the United States Department of the Interior, Bureau of Land Management or by a decree of a Court of Law and/or that the corner points mentioned in lines 3, 4 and 5 above were in conformance with the rules of the Michigan Board of Land Surveyors or by a Decree of a Court of Law; established, re-established, monumented, recovered, found as expressed below:

1	A	B	C	D	E	F	G	H	I	J	K	L	M
2	6		5		4		3		2		1		
3													
4	7		8		9		10		11		12		
5													
6	18		17		16		15		14		13		
7													
8	19		20		21		22		23		24		
9													
10	30		29		28		27		26		25		
11													
12	31		32		33		34		35		36		
13													

NOTE: Not more than 2 corners, all in the same town and range, may be recorded on this certificate.

A. Description of original monument and accessories and/or subsequent restoration:

M-5 GLO, 1831	HEI inform., no dates	Stone
Lucius Lyon, DS	3/4" steel bar	24" Walnut NW 37.50'
Set post Secs. 12 & 13	PP N 30° E 49.70'	36" Elm NW 63.50'
Beech 10 N 11 W 27	Sq. fence post S 60° E 53.66'	
Sugar 16 S 16 W 17	36" Maple N 40° W 31.46'	North 5274.6'
	PP S 50° W 178.04'	
Common Corner A-5 (NW 18, 4-13)		<u>OVER</u>

B. Description of corner evidence found and/or method applied in restoring or reestablishing corner:

M-5 Found 3/4" solid rod in Mon. Box in bit.  
C/L bit. E-W is South 1'±  
PP N 30° E 49.70'±  
PP S 50° W 178.04'±  
Sq. fence post S 60° E 53.66'


APPROVED REMONUMENTATION CORNER  
P.A. 345 OF 1990  
ALLEGAN COUNTY  
DATE APPROVED JUNE 9, 1998  
COUNTY REP. [Signature]

Peer group approved 6-9-98.

And is accepted as a careful and faithful perpetuation of the position of the original corner.

C. Description of monument for corner and accessories established to perpetuate locating the position of the corner:

M-5 Placed Allegan Co. Cap on rod in Mon. Box  
Nail & Allegan Co. Remon. Tag in SE side PP N 35° E 49.73'  
Nail & Allegan Co. Remon. Tag in NW side PP S 50° W 177.94'  
Nail & Allegan Co. Remon. Tag in N side PP N 50° W 60.41'  
Nail & Allegan Co. Remon. Tag in top of 1'x1' fence post S 50° E 55.10'  
C/L bit. E-W is South 1'±; C/L gravel N-S is East 5'±

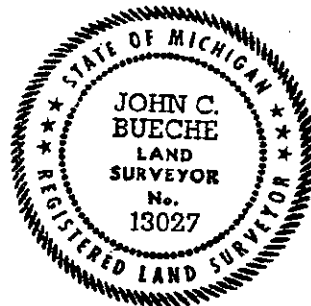

Signed by John C. Bueche  
Surveyor's Michigan License No. 13027

Date 6-4-98

SURVEY  
REMONUMENTATION

APR 29 1933

✓ A-5 SALEM TWP.  
M-5 OVERISEL TWP.  
PART A - continued

SECTION

A-5 (NW 18)  
HEI inform. sheet  
Bent iron over stone 1967  
Gas line marker NW 29.0'  
28" Ash NW 29.7'  
TP WSW 55.8'  
Stop sign SW 30.8'  
TP SE 64.0'

A-5 (NW 18)  
LCRC 1-387, July, 1972, Ratekin  
Fnd. 1" iron  
Gas line marker N 50° W 29.0'  
30" Ash N 40° W 29.6'  
St. sign S 45° E 47.15'  
L/C S. end 12" conc.

LIBERO 007 PAGED 60

