

**SURVEY
REMONUMENTATION**

APR 29 1999

SECTION

**Allegan County Remonumentation
LAND CORNER RECORDATION CERTIFICATE
Filing Requirement of Act 74, Mich. P.A. 1970**

LIBR0007 PAGE052

For corners in

<u>Allegan</u> (County)	Located In:	Corner Code #
1. Public Land Survey	T <u>4N</u> R <u>14W</u>	M-6 (E $\frac{1}{2}$, 13) Overisel Twp.
	T ___ R ___	_____
	T ___ R ___	_____
	T ___ R ___	_____
2. Property Controlling in Section	S ___ T ___ R ___	_____
	S ___ T ___ R ___	_____
3. Miscellaneous Property in Sec.	S ___ T ___ R ___	_____
	S ___ T ___ R ___	_____
4. Lot No. _____, Recorded Plat _____		
5. Private Claims _____		

FILED
1/28/1999 2:44:39 PM
JOYCE A. WATTS
REGISTER OF DEEDS
ALLEGAN COUNTY, MICH
Register of Deeds Stamp & File Number

I, John C. Bueche, in a field survey on May 7, 19 98 do hereby state that under requirements of P.A. 74, Michigan P.A. of 1970, the corner points mentioned in lines 1 and 2 above were in conformance with regulations and rules therefore as required in the current manual of survey instructions of the United States Department of the Interior, Bureau of Land Management or by a decree of a Court of Law and /or that the corner points mentioned in lines 3, 4 and 5 above were in conformance with the rules of the Michigan Board of Land Surveyors or by a Decree of a Court of Law, established, re-established, monumented, recovered, found as expressed below:

A	B	C	D	E	F	G	H	I	J	K	L	M
1												
2	6		5		4		3		2		1	
3												
4	7		8		9		10		11		12	
5												
6	18		17		16		15		14		13	
7												
8	19		20		21		22		23		24	
9												
10	30		29		28		27		26		25	
11												
12	31		32		33		34		35		36	
13												

NOTE: Not more than 2 corners, all in the same town and range, may be recorded on this certificate.

- A. Description of original monument and accessories and/or subsequent restoration:
 M-6 GLO, 1831
 Lucius Lyon, DS
 Set qr. Sec. post
 Beech 9 N 7 W 26
 Beech 4 S 8 1/2 W 21
 Survey Feb., 1992, Van Order
 Fnd. capped iron (True Line)
 PP NE 30.75'
 PP WSW 56.82'
 10" Oak SW 72.48'
 8" Oak SSW 68.31'

APPROVED REMONUMENTATION CORNER
 P.A. 345 OF 1990
 ALLEGAN COUNTY
 DATE APPROVED JUNE 9, 1998
 COUNTY REP. [Signature]

B. Description of corner evidence found and/or method applied in restoring or reestablishing corner:


M-6 Found capped rerod on C/L gravel road N-S
 As per above wit.

Peer group approved 6-9-98,

And is accepted as a careful and faithful perpetuation of the position of the original corner.

C. Description of monument for corner and accessories established to perpetuate locating the position of the corner:

- M-6 Replaced rerod with 3/4" x 36" Pin with Allegan Co. Cap in gravel road
- Nail & Allegan Co. Remon. Tag in S side PP N 70° E 30.63'
- Nail & Allegan Co. Remon. Tag in N side 12" Poplar N 30° W 63.82'
- Nail & Allegan Co. Remon. Tag in N side 10" Oak N 70° W 49.04'
- Nail & Allegan Co. Remon. Tag in N side PP S 70° W 56.91'
- Nail & Allegan Co. Remon. Tag in E side 12" Oak S 30° W 68.09'
- Allegan Co. Mon. A-6 (W 1/4 18, 4-13) North 16.74'
- North edge of woods North 155'±
- On C/L gravel road N-S; C/L dr. West, South 33'±

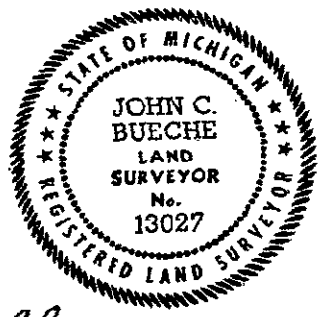

Signed by John C. Bueche
 Surveyor's Michigan License No. 13027

Date 6-4-98