

RF

MAR 07 2000

ALLEGAN COUNTY REMONUMENTATION
LAND CORNER RECORDATION CERTIFICATE
Filing Requirement of Act 74, Mich. P.A. 1970

SECTION

For corners in

<u>Allegan</u> (County)	Located In:	Corner Code #
1. Public Land Survey	T <u>4N</u> R <u>14W</u>	<u>M-12</u>
	T ___ R ___	<u>Overisel</u> Twp.
	T ___ R ___	_____
	T ___ R ___	_____
2. Property Controlling in Section	S ___ T ___ R ___	_____
	S ___ T ___ R ___	_____
3. Miscellaneous Property in Sec.	S ___ T ___ R ___	_____
	S ___ T ___ R ___	_____

REGISTER OF DEEDS
ALLEGAN COUNTY, MICH.
James A. ...

00 FEB - 1 AM 8:49

FILED
LIBER 007 PAGE 20

Register of Deeds Stamp & File Number

4. Lot No. _____, Recorded Plat _____
5. Private Claims _____

I, Kirk L Van Order in a field survey on Nov 1, 1999 do hereby state that under requirements of P.A. 74, Michigan P.A. of 1970, the corner points mentioned in lines 1 and 2 above were in conformance with regulations and rules therefore as required in the current manual of survey instructions of the United States Department of the Interior, Bureau of Land Management or by a decree of a Court of Law and/or that the corner points mentioned in lines 3, 4 and 5 above were in conformance with the rules of the Michigan Board of Land Surveyors or by a Decree of a Court of Law; established, re-established, monumented, recovered, found as expressed below:

NOTE: Not more than 2 corners, all in the same town and range, may be recorded on this certificate.

1	A	B	C	D	E	F	G	H	I	J	K	L	M
2	6		5		4		3		2		1		
3													
4	7		8		9		10		11		12		
5													
6	18		17		16		15		14		13		
7													
8	19		20		21		22		23		24		
9													
10	30		29		28		27		26		25		
11													
12	31		32		33		34		35		36		
13													

A. Description of original monument and accessories and/or subsequent restoration:

M-12

- (1) GLO North East side Section 36 40.00 chains Set quarter Section post
Beech 6 N.43°W. 29
W. Oak 10 S.49°W. 18
- (2) LCRC, Liber 1 on Page 392, by Donald A. Ratekin, dated June 16, 1972
Set 1" iron
30" maple N.20°E. 84.0'

(continued on back of sheet)

B. Description of corner evidence found and/or method applied in restoring or reestablishing corner:

M-12

Fd. 1" x 1.8' iron and the following tie witnesses:

- 30" maple N.20°E 84.0' (now 38" dead maple)
- Occupation to East N. 8.5'
- P.P. West 29.43'
- 42" (now 52") maple E.NE 80.98'
- 35" (now 36") oak W.,SW 69.58'
- 19" (now 21") ash S.,SW 82.47'

APPROVED REMONUMENTATION CORNER
P.A. 345 OF 1990
ALLEGAN COUNTY
DATE APPROVED Nov. 9, 1999
COUNTY REP. *[Signature]*

Replaced 1" iron with a standard Allegan Co. Remon. monument and is accepted as a careful and faithful perpetuation of the position of the original corner. Peer group approved Nov. 9, 1999.

C. Description of monument for corner and accessories established to perpetuate locating the position of the corner:


M-12

Standard Allegan Co. Remon. monument (3/4" x 24" steel rod w/red cap #23520)

- Nail & Remon. tag in S side 52" maple N.80°E. 81.02'
- Nail & Remon. tag in NE side 17" r. oak S.40°E. 44.03'
- Nail & Remon. tag in SE side 12" w. pine S.45°W. 38.86'
- Nail & Remon. tag in N side 36" w. oak S.90°W. 69.19'
- Nail & Remon. tag in N side power pole N.85°W. 29.38'
- C/L gravel road N.90°E. 4.5'
- Fd. capped iron N.0°E. 8.50'

Signed by *[Signature]*
Surveyor's Michigan License No. KIRK L VAN ORDER 23520

Date 12-30-1999

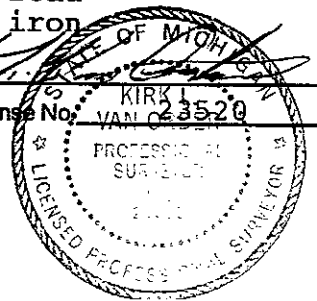

RE...

MAR 07 2000

SECTION

Section A (continued from Page 1)

M-12

Overisel Twp., T.4N., R.14W.

- | | | |
|--|---------|--------|
| N. gate post | N.50°E. | 43.7' |
| Occupation to East | North | 8.5' |
| C/L 36th St. | East | 5.6' |
| 3. D.A.R. corner card Sec. 36, Overisel Twp. | | |
| 1" iron April 72 | | |
| 30" maple | N.20°E. | 84.0' |
| N. gate post | N.50°E. | 45.50' |
| 12" | N.85°E. | 34.35' |
| Occupation line to East | North | 8.5' |
| C/L 36th St. | East | 5.6' |
| P.P. | West | 29.43' |
| Capped iron (Jonker) | North | 8.48' |
| 4. Allegan Co. Road Commission | | |
| E. 1/4 (KVO) | | |
| 42" maple | E.NE | 80.98' |
| 38" maple | N.NE | 85.51' |
| 35" oak | W.SW | 69.58' |
| 19" ash | S.SW | 82.47' |
| 5. Holland Eng., Inc. | | |
| Same info as in No. 2 | | |
| 6. Kirk L. Van Order, R.L.S. survey dated April 24, 1984 | | |
| Fd. 1" steel rod | | |
| Same info as in No. 4 | | |

MEMORANDUM 7 APR 14 21